


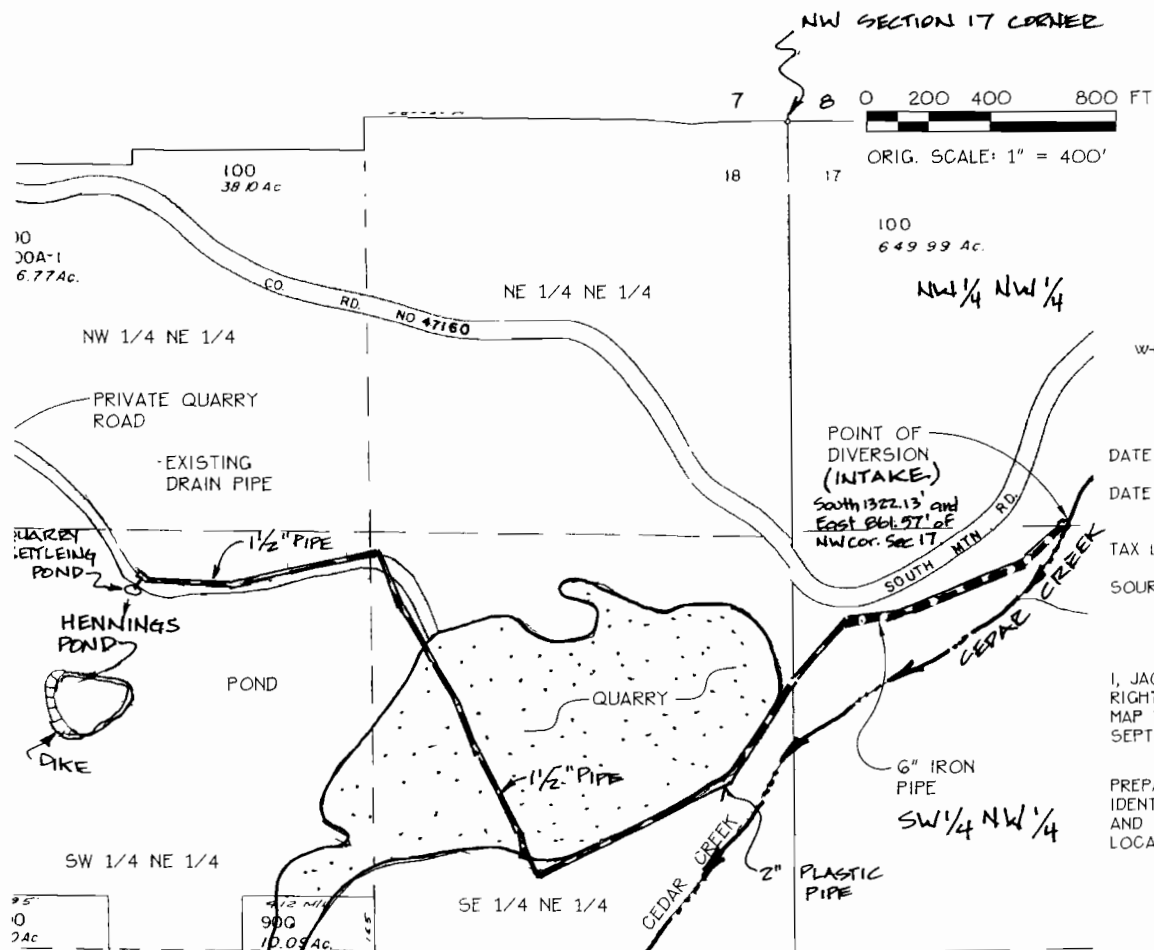

MAP OF BENEFICIAL USE  
UNDER  
PERMIT No. R-11532 + PERMIT No. 51593  
IN NAME OF

GRACE HENNING'S TRUST  
C/O BILL HENNING'S, CO-TRUSTEE  
+ JUDY BUTLER, CO-TRUSTEE  
1950 POPCORN ST NW  
SALEM, OR 97304

Located IN  
SECTIONS 17 and 18, T.14S.,  
R. 7 W., W.M., BENTON CO., OREGON

DATE OF SITE INSPECTION: SEPTEMBER 23, 2003

DATE OF MAP: SEPTEMBER 30, 2003

TAX LOT: 200 (14-7W-18)

SOURCE CEDAR CREEK, A TRIBUTARY OF SOUTH FORK  
ALSEA RIVER

I, JACK R. BURRELL, BEING DULY SWORN AS A WATER  
RIGHT EXAMINER, LICENSE No. 209, HAVE PREPARED THIS  
MAP FOR GRACE HENNING'S TRUST ON THIS 30TH DAY OF  
SEPTEMBER 2003.

PREPARATION OF THIS MAP IS FOR THE PURPOSE OF  
IDENTIFYING THE LOCATION OF THE WATER RIGHT ONLY  
AND HAS NO INTENT TO PROVIDE DIMENSIONS OF  
LOCATION OF PROPERTY OWNERSHIP LINES.

