
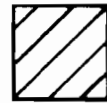


# T.10S., R.1W., W.M.

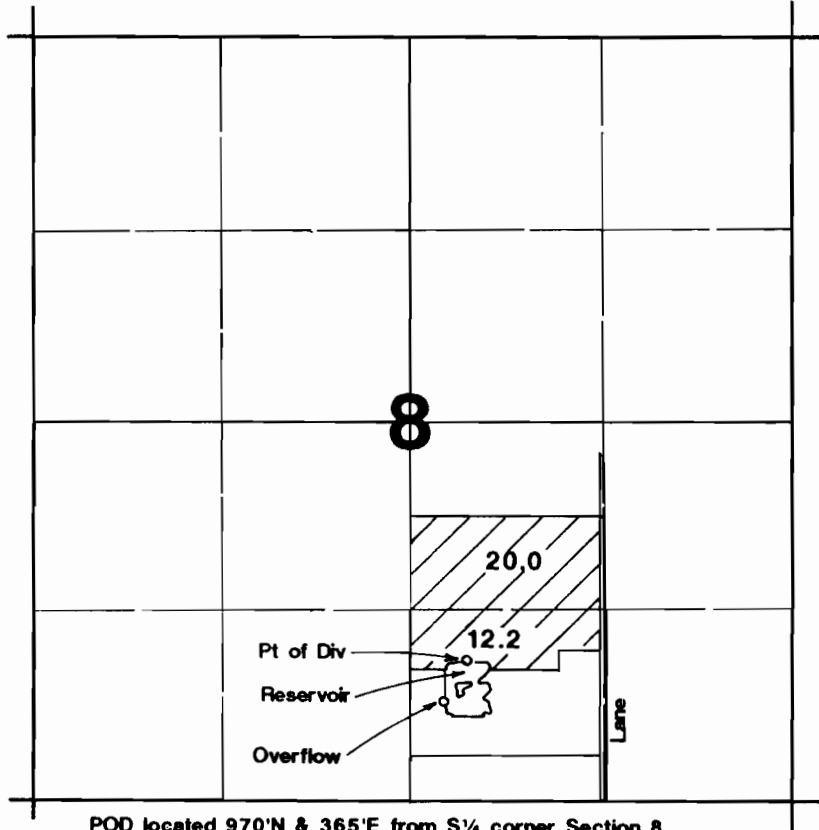

Area Irrigated

POD located 970'N & 365'E from S¼ corner Section 8.  
Overflow located 640'N & 200'E from S¼ corner Section 8.

**RECEIVED**

**JAN 28 1997**

**WATER RESOURCES DEPT.  
SALEM, OREGON**

## Final Proof Survey

Application #: R-72277  
72278

Permit #: R-11555  
51669

In Name Of

### Carl F. & Laquita Stec

Surveyed on September 24, 1996 by JM Schuette

THIS MAP WAS PREPARED FOR THE PURPOSE OF IDENTIFYING THE LOCATION OF A WATER RIGHT ONLY AND IS NOT INTENDED TO PROVIDE LEGAL DIMENSIONS OR LOCATION OF PROPERTY OWNERSHIP LINES.

