


T.10S., R.1W., W.M.

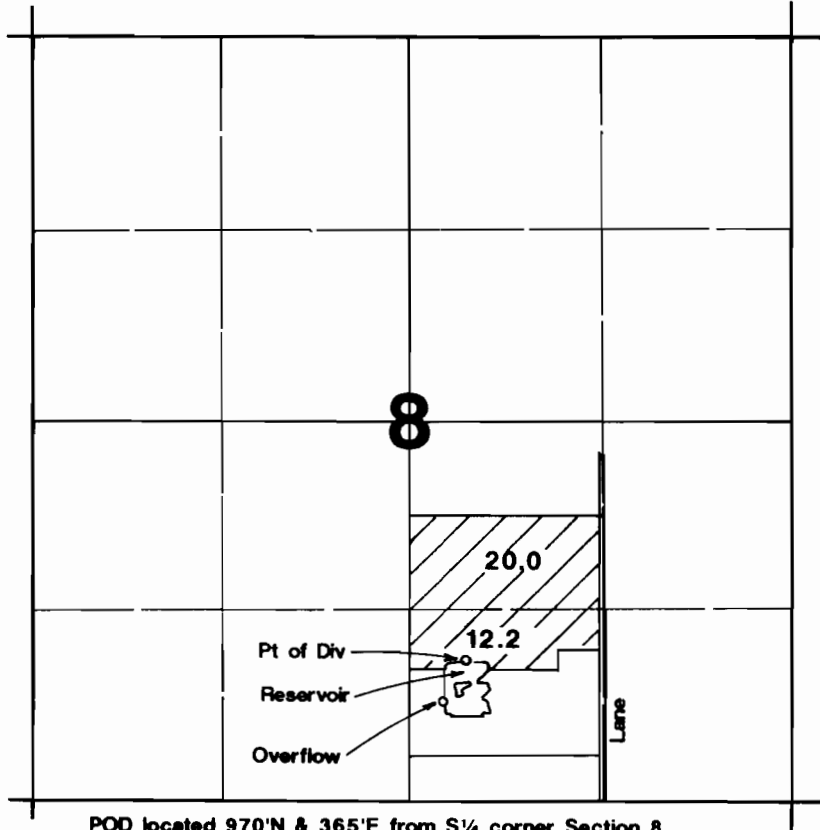

POD located 970'N & 365'E from S $\frac{1}{4}$ corner Section 8.
Overflow located 640'N & 200'E from S $\frac{1}{4}$ corner Section 8.

Final Proof Survey

Application #: R-72277
72278

Permit #: R-11555
51669

RECEIVED

JAN 28 1997

In Name Of

Carl F. & Laquita Stec

WATER RESOURCES DEPT.
SALEM, OREGON

Surveyed on September 24, 1996 by JM Schuette

THIS MAP WAS PREPARED FOR THE PURPOSE OF IDENTIFYING THE LOCATION OF A WATER RIGHT ONLY AND IS NOT INTENDED TO PROVIDE LEGAL DIMENSIONS OR LOCATION OF PROPERTY OWNERSHIP LINES.

