


RECEIVED


SEP 24 1999

WATER RESOURCES DEPT.
SALEM, OREGON

T 2 S R 38 E

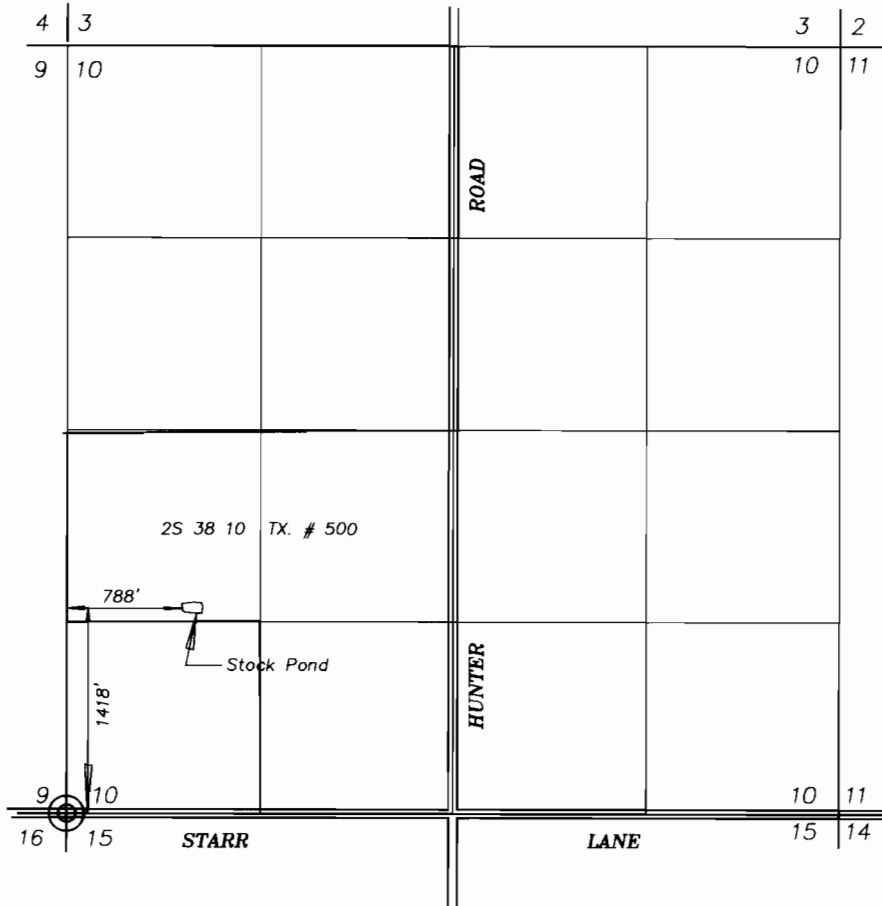

SCALE 1" = 1320'

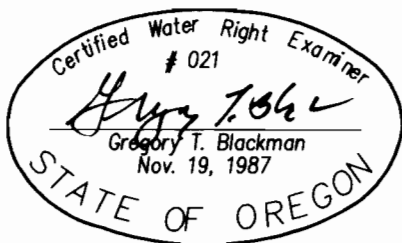

FINAL PROOF MAP FOR
WATER RIGHTS ON ONE
STOCK POND
FOR
THOMAS E. AND JANICE I. KOHR

BY
BAGETT - GRIFFITH & BLACKMAN
2006 ADAMS AVENUE
LAGRANDE, OREGON 97850

SEPTEMBER 1, 1999

APPLICATION NO. R- 76190

PERMIT NUMBER R- 11845

NOTE: The preparation of this map was for the purpose of identifying the location of the proposed water right and has no intent to provide dimensions or location of property ownership lines. Location information shown hereon was furnished by the applicant.