


RECEIVED

SEP 23 1999


WATER RESOURCES DEPT.
SALEM, OREGON

Lot 4

T13S R3W, WM

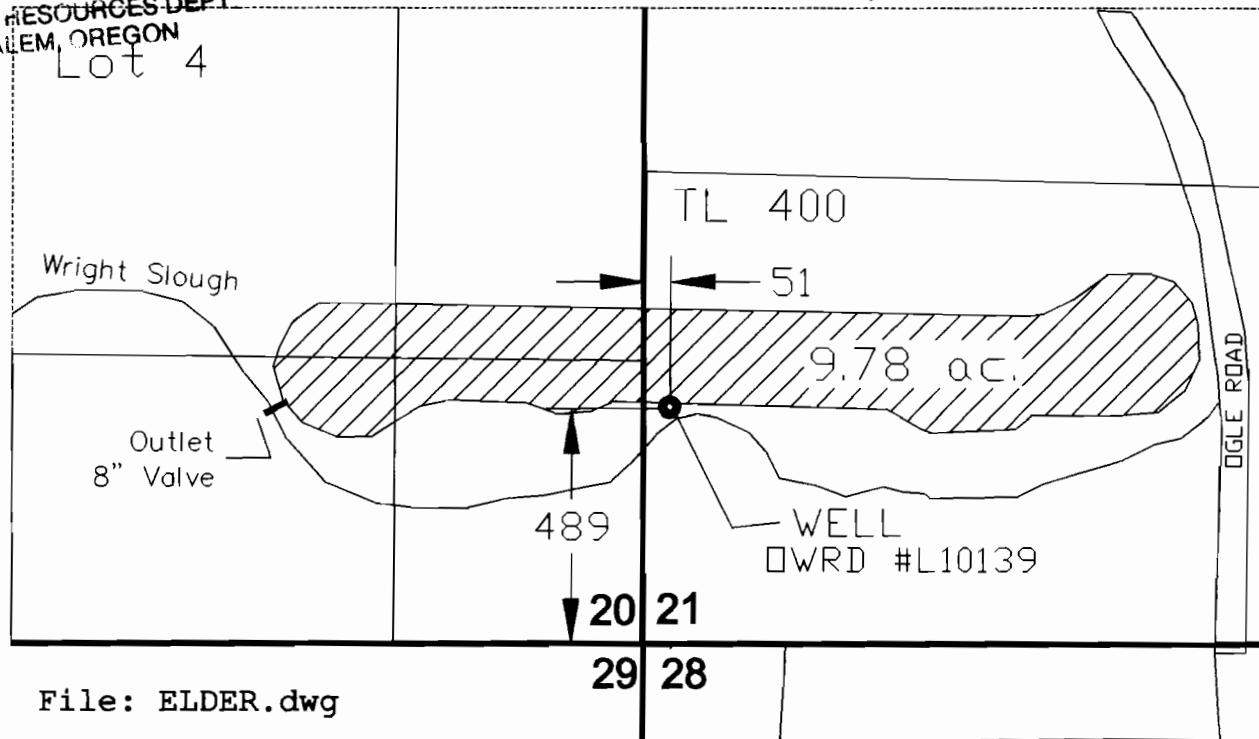

File: ELDER.dwg

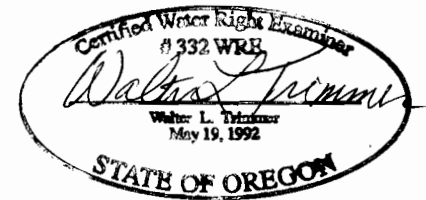

EXP JUN 30 2000

**FINAL PROOF SURVEY
UNDER**

Scale 1"=400ft.

Application No.G-14211 Permit No. G-12927
Application No.R-80675 Permit No. R-11829

**in the name of
Mark Elder**

Surveyed 11/14/98 by Walter L Trimmer, CWRE 332