


# FINAL PROOF SURVEY

IN THE NAME OF GARY LEE MILLER LLC  
SECTION 27, T.1N., R.5E., W.M.  
SCALE 1 INCH = 400 FEET

## RECEIVED

DEC 28 2007

WATER RESOURCES DEPT  
SALEM, OREGON

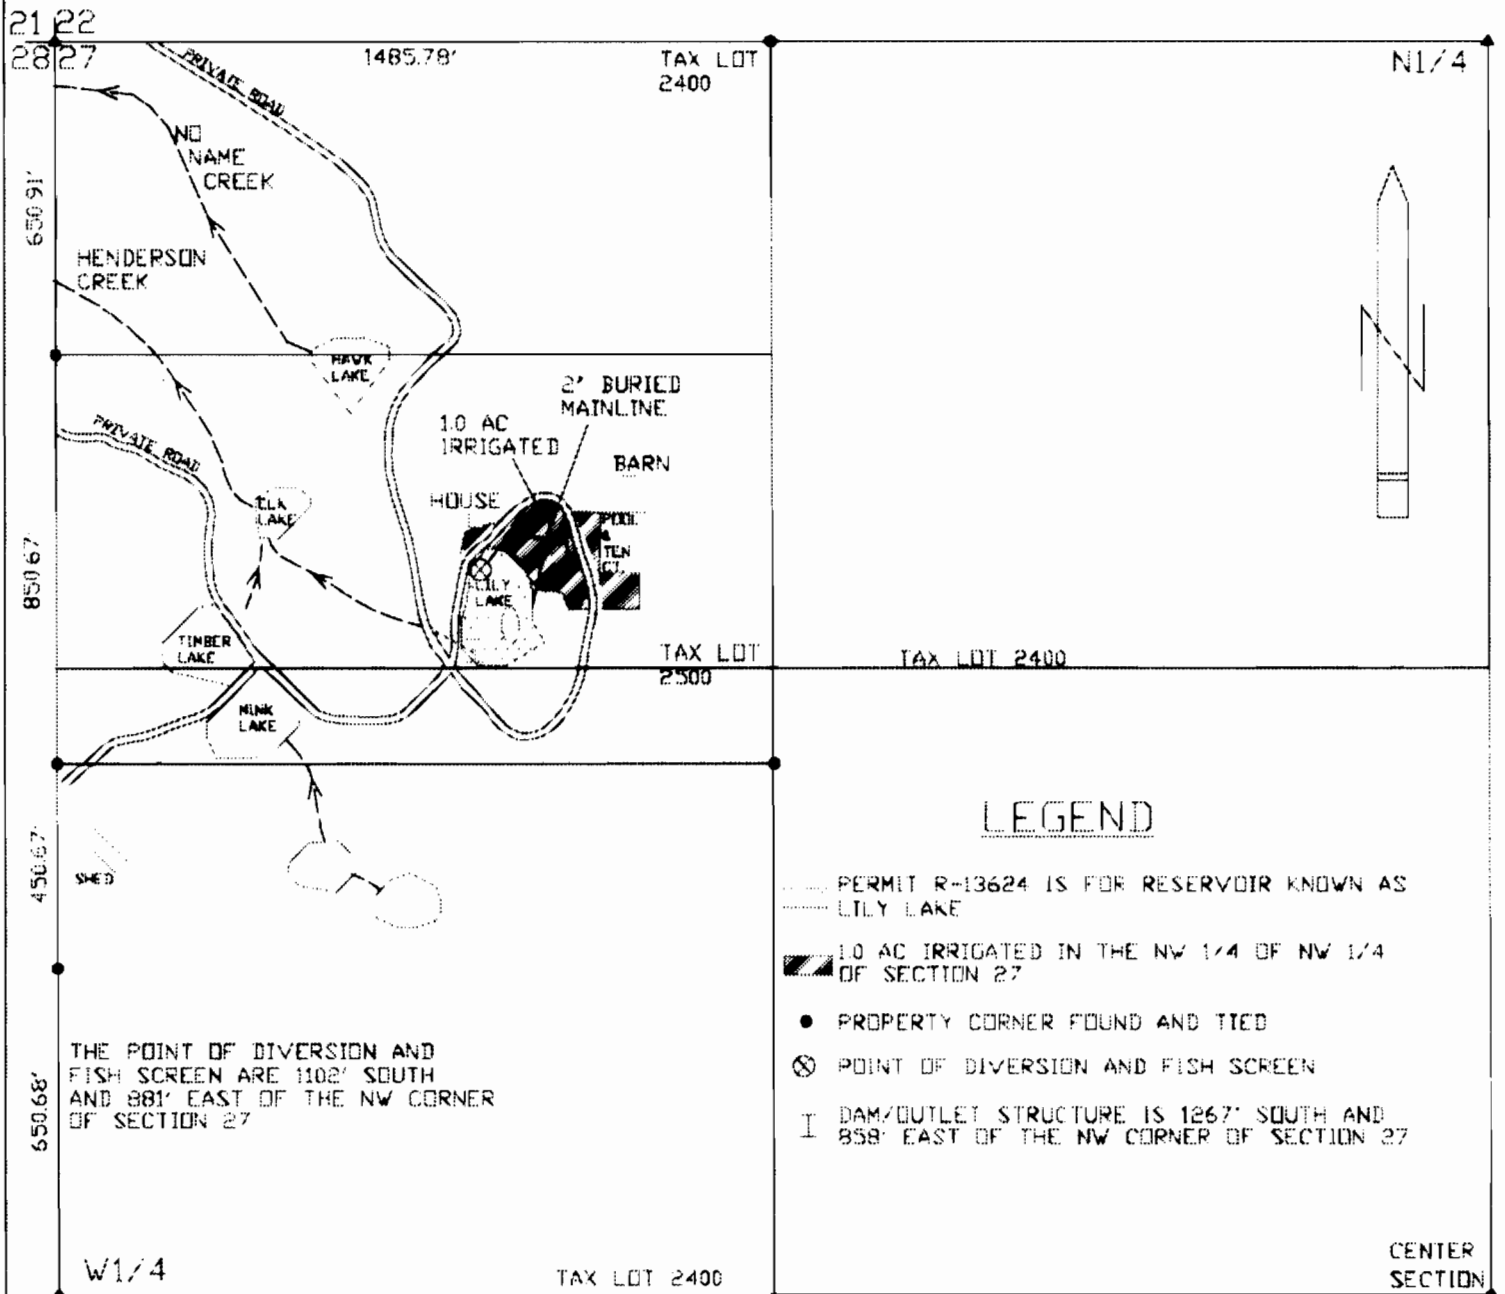


BASIS OF BEARING P.S.52773

FOR:

- APPLICATION #R-85447  
PERMIT #R-13624
- APPLICATION #S-85467  
PERMIT #53954

SURVEYED NOV 3, 2007

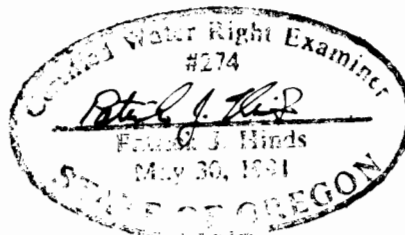

THIS MAP IS NOT  
INTENDED TO PROVIDE  
LEGAL DIMENSIONS OR  
LOCATIONS OF PROPERTY  
OWNERSHIP LINES