


FINAL PROOF SURVEY

IN THE NAME OF GARY LEE MILLER LLC
SECTION 27, T.1N., R.5E., W.M.
SCALE 1 INCH = 400 FEET

RECEIVED

DEC 28 2007

WATER RESOURCES DEPT
SALEM, OREGON

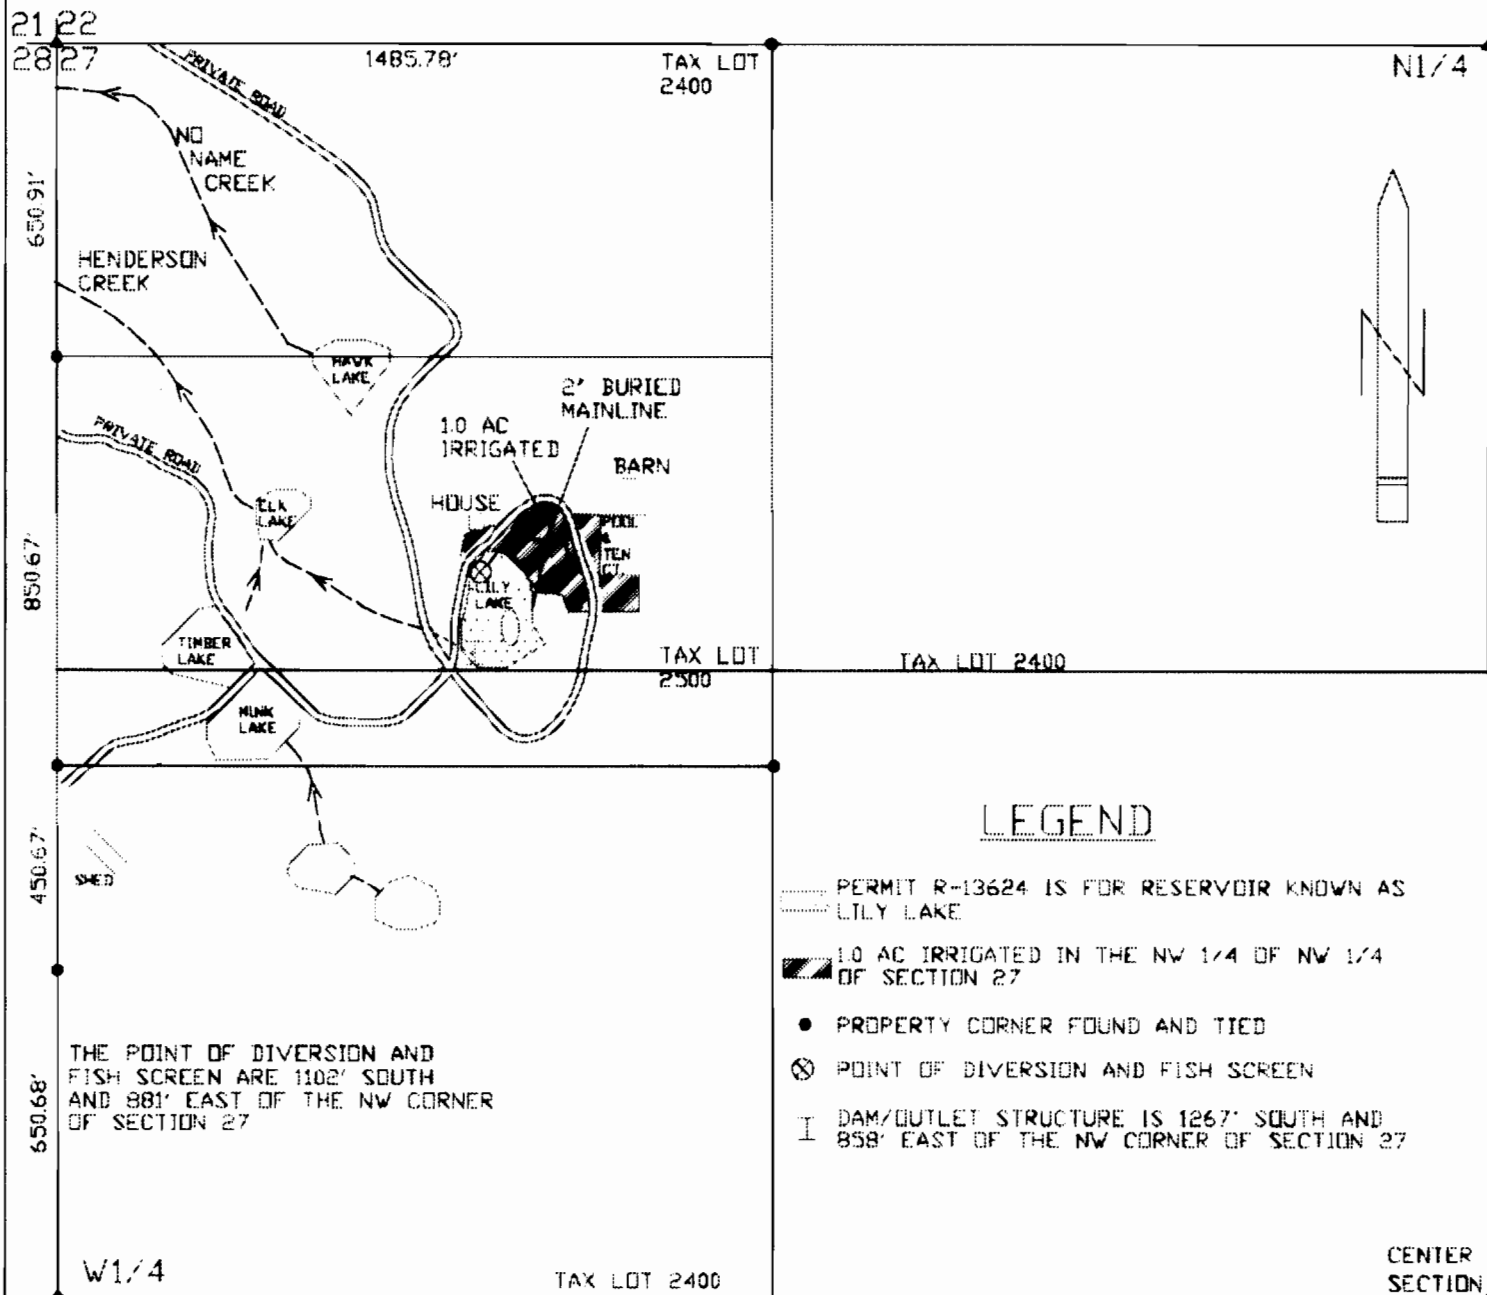


BASIS OF BEARING P.S.52773

FOR:

- APPLICATION #R-85447
PERMIT #R-13624
- APPLICATION #S-85467
PERMIT #53954

SURVEYED NOV 3, 2007

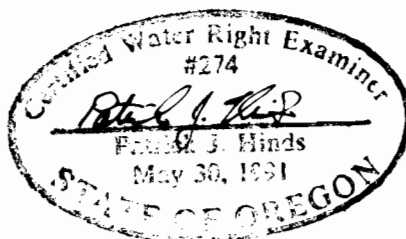

THIS MAP IS NOT
INTENDED TO PROVIDE
LEGAL DIMENSIONS OR
LOCATIONS OF PROPERTY
OWNERSHIP LINES