



T.36S.,R.1W.,W.M.

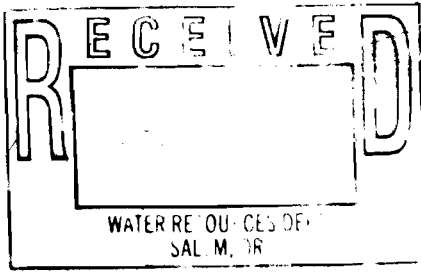

SCALE 1" = 1320'

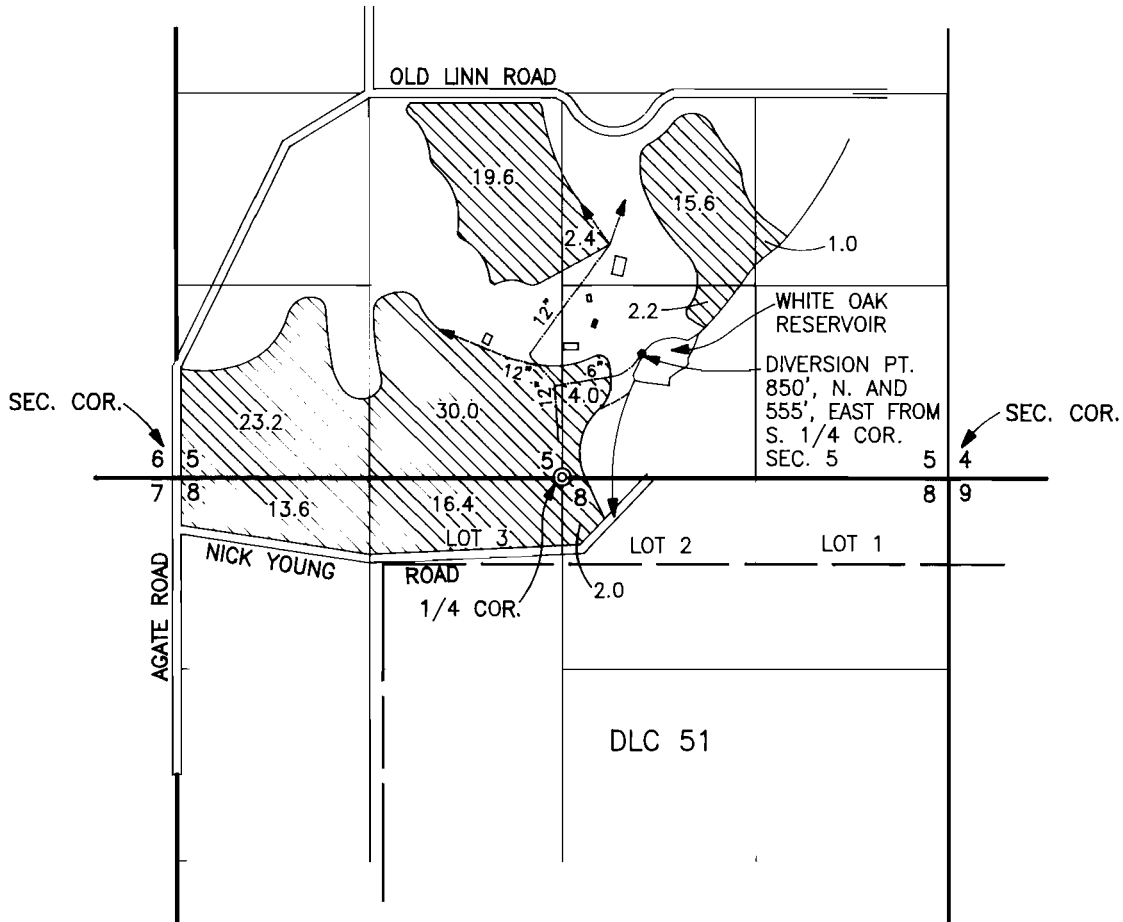

FINAL PROOF MAP

APPLICATION No. S-77840  
PERMIT No. 53069

NOTE: MAP PREPARED FOR  
WATER RIGHT PURPOSES ONLY,  
NOT FOR PROPERTY BOUNDARY  
LOCATIONS.

IN THE NAME OF  
WHITE OAK RANCH

 = 130 ACRES  
SUPPLEMENTAL IRRIGATION

MAP PREPARED APRIL 19, 2000 BY GARY D. KAISER

