



T.36S.,R.1W.,W.M.

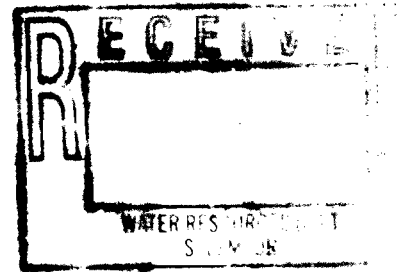

SCALE 1" = 400'

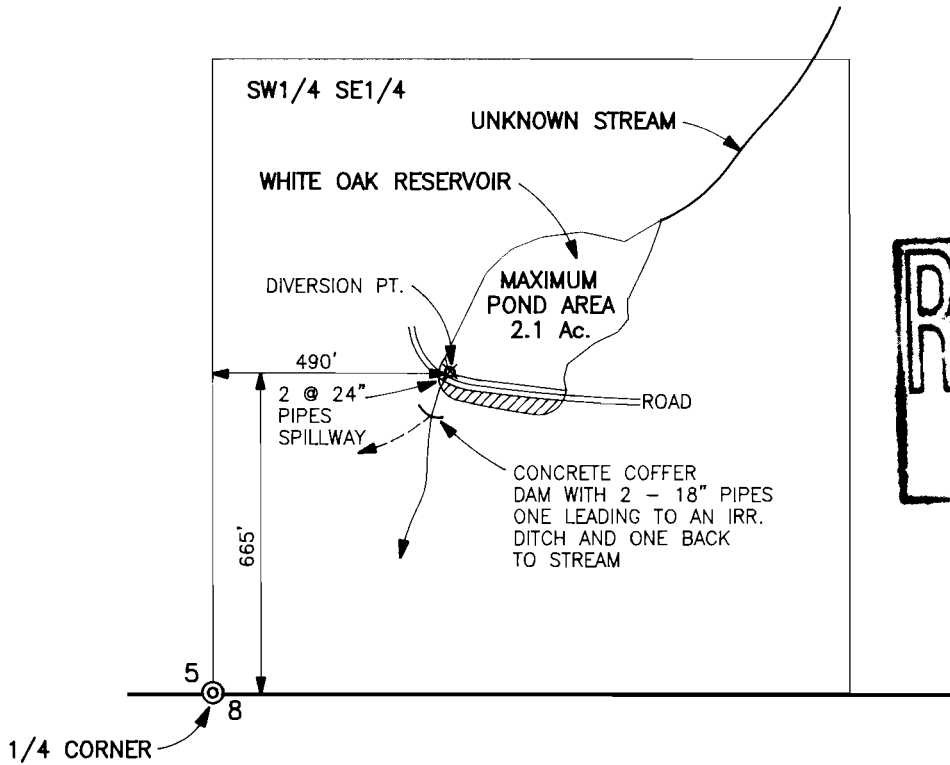

FINAL PROOF MAP
APPLICATION No. R-77839
PERMIT No. R-12144

NOTE: MAP PREPARED FOR
WATER RIGHT PURPOSES ONLY,
NOT FOR PROPERTY BOUNDARY
LOCATIONS.

IN THE NAME OF
WHITE OAK RANCH

MAP PREPARED APRIL 19, 2000 BY GARY D. KAISER

