



T. 16 S., R. 3 E., W.M.

RECEIVED

JUN 14 1996

SECTION 32

WATER RESOURCES DEPT.
SALEM, OREGON

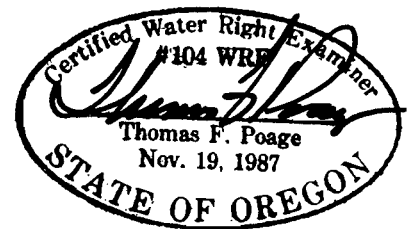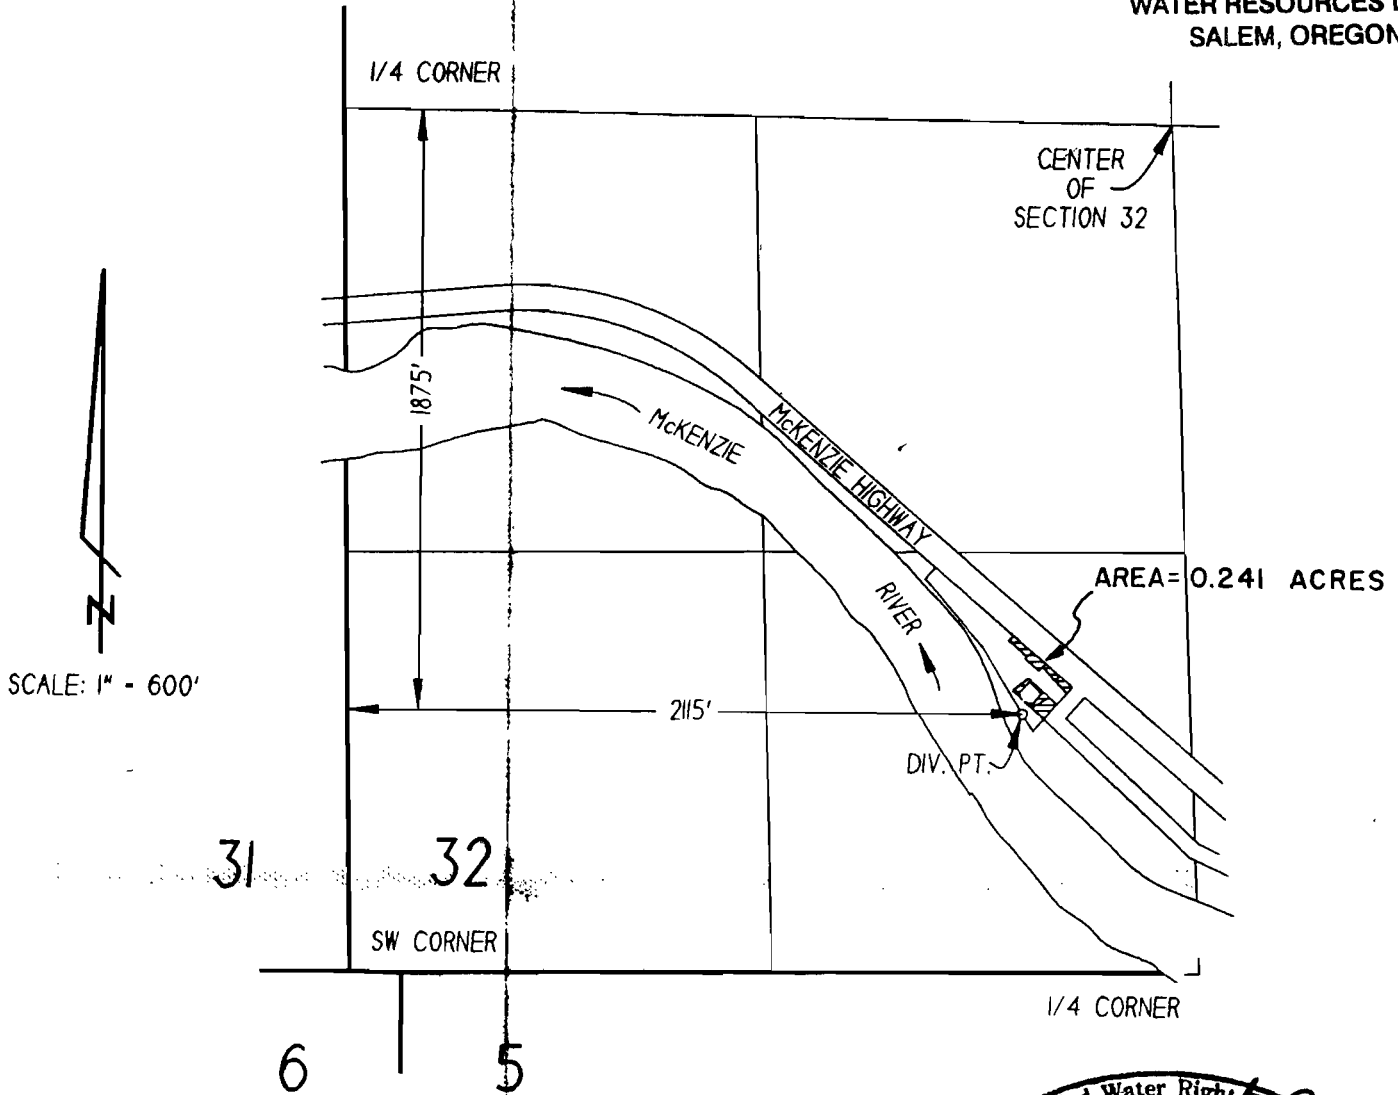

FINAL PROOF SURVEY
UNDER

APPLICATION No. 71821, PERMIT No. 51537

IN NAME OF

Paul G. & Al Verta J. Williamson

SURVEYED MAY 29, 1996, by THOMAS F. POAGE.