


T.7S., R.3W., W.M.

RECEIVED

JUL 25 2005

WATER RESOURCES DEPT
SALEM, OREGON

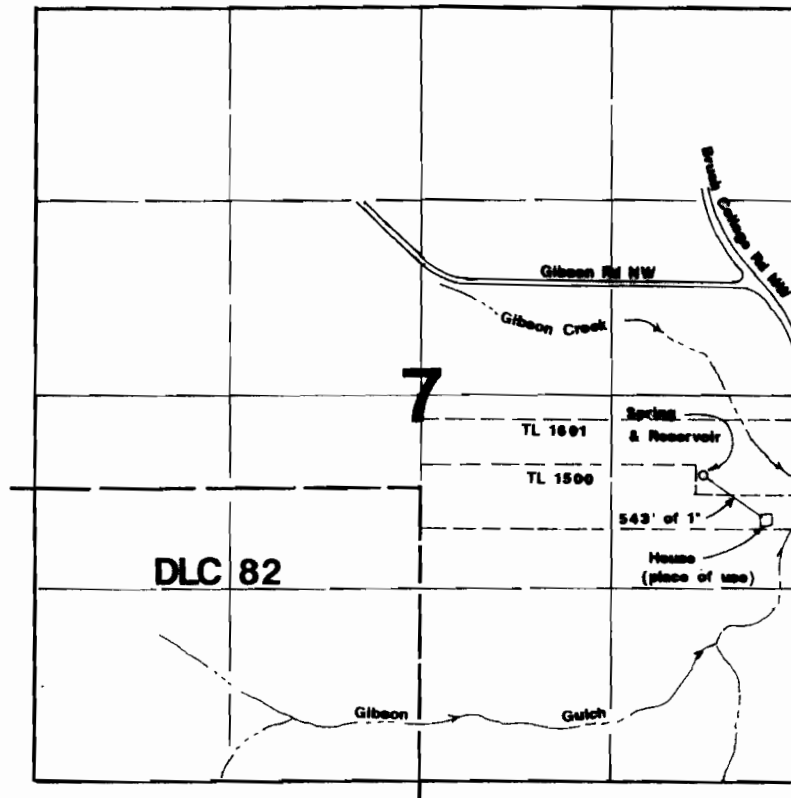

1" = 1320'

Spring is located 1940'E & 95'N from the NE corner of DLC 82.

Final Proof Survey

In the Name of

Kirk & Shirley Bartruff

Application #: S-84243 Permit #: S-53696

Surveyed on June 2, 2005 by JM Schuette

This Map was Prepared for the Purpose of Identifying the Location of a Water Right Only and is Not Intended to Provide Legal Dimensions or Location of Property Ownership Lines

