

**Claim of Beneficial Use
Place of Use Map
Application G-12801;
Permit G-11416**

**City of Sisters
Deschutes County, Oregon**

**Sections 4, 5, 8, & 9
Township 16 South
Range 10 East (W.M.)**


Legend

- Point of Appropriation (POA)
- ▨ Place of Use (POU) according to Permit G-11416
- ⊕ Tax Lots
- ~ Watercourses

Map Information
 Projection: Oregon State Plane South Zone
 Datum: North American Datum of 1983
 Date: July 25, 2008
 Prepared By: GSI Water Solutions, Inc.


Data Source
 Deschutes County GIS, Oregon Geospatial Data Clearinghouse

Disclaimer
 This map was prepared for the purpose of identifying the location of a water right only and it is not intended to provide legal dimensions or location of property ownership lines.

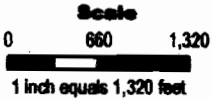

Certified Water Rights Examiner
 #78208WRE
Bruce Brody-Heine
 Bruce Brody-Heine
 June 29, 2007
STATE OF OREGON
 EXPIRES: 12-31-09

Claim of Beneficial Use - Well Location Map
Application G-12591; Permit G-11418
 City of Sisters
 Deschutes County, Oregon
 Section 5, Township 15 South, Range 10 East (W.M.)

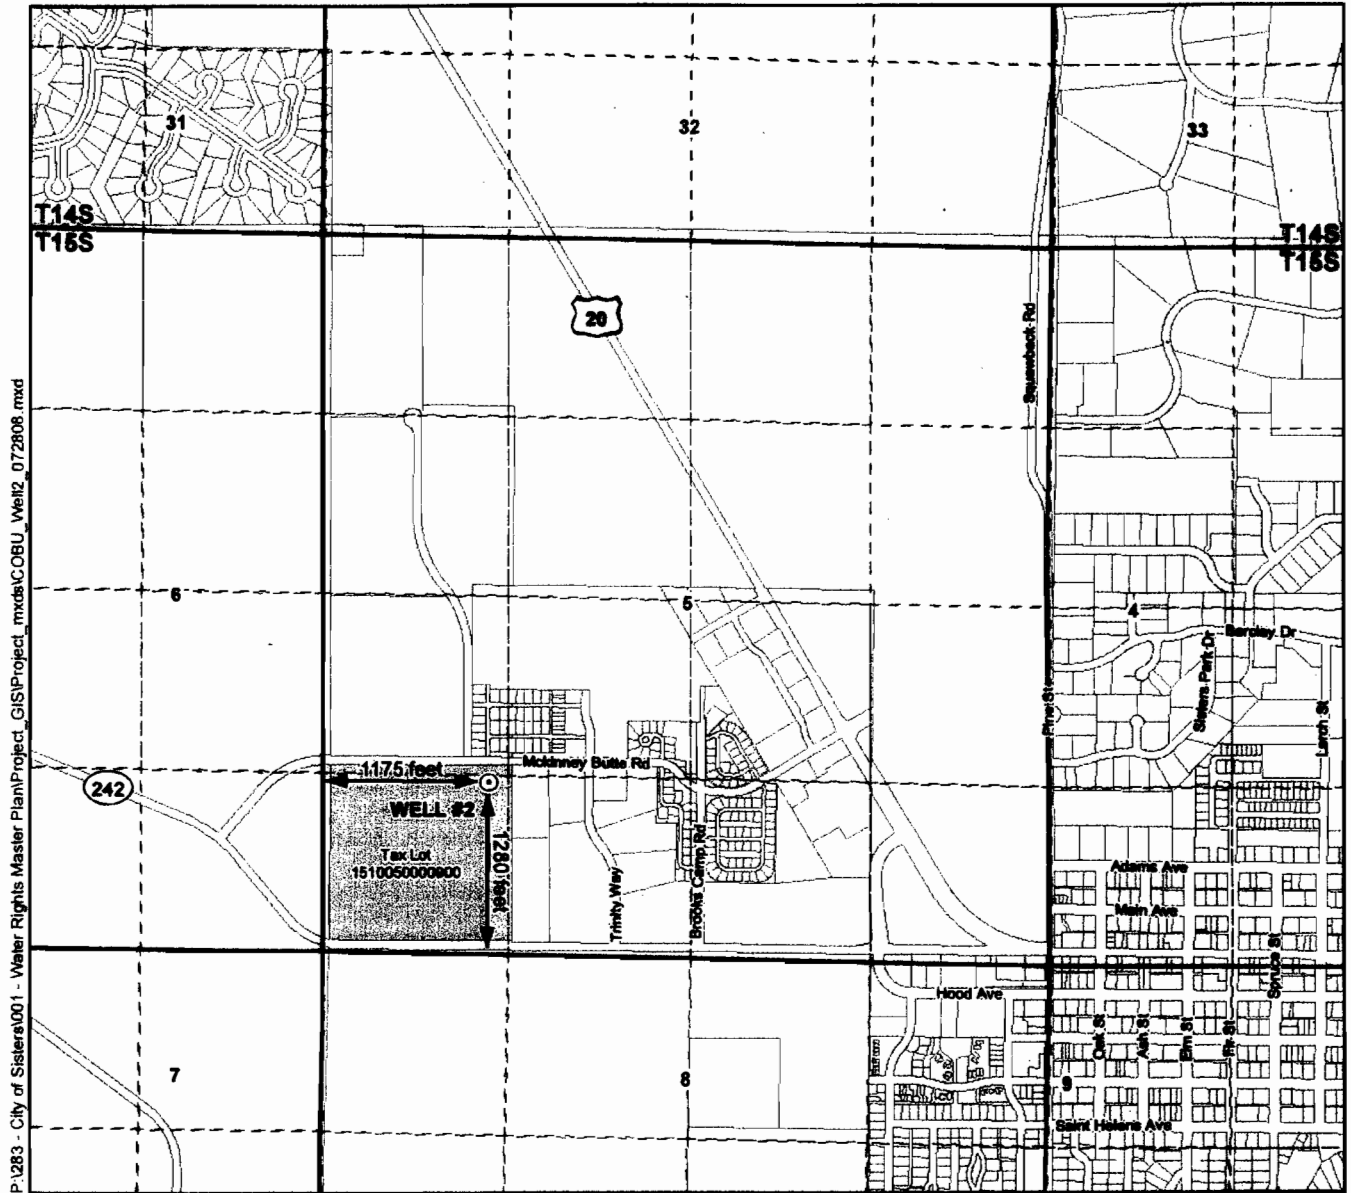

P:\283 - City of Sisters\001 - Water Rights Master Plan\Project_GIS\Project_mxd\CA\OBU_Well2_072808.mxd

Legend


- ⊙ Point of Appropriation (POA)
- ⊕ Tax Lots

NOTES:

- 1) Water meters are located inside the well house approximately 10 feet downstream of the wellhead.
- 2) Conveyance System: Refer to the system overview map in Attachment 1.

POA Location Description

Well #2
 Located 1,260 feet North and 1,175 feet East from the SW corner of Section 5, Township 15 South, Range 10 East (W.M.), being within Tax Lot 1510050000900

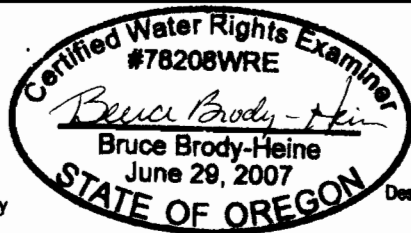

EXPIRES: 12-31-09

Map Information
 Projection: Oregon State Plane South Zone
 Datum: North American Datum of 1983
 Date: July 28, 2008
 Prepared By: GSI Water Solutions, Inc.

Data Sources
 Deschutes County GIS, Oregon Geospatial Data Clearinghouse

Disclaimer
 This map was prepared for the purpose of identifying the location of a water right only and it is not intended to provide legal dimensions or location of property ownership lines.

