


T. 6 S., R. 1 W., W. M.

MARION COUNTY

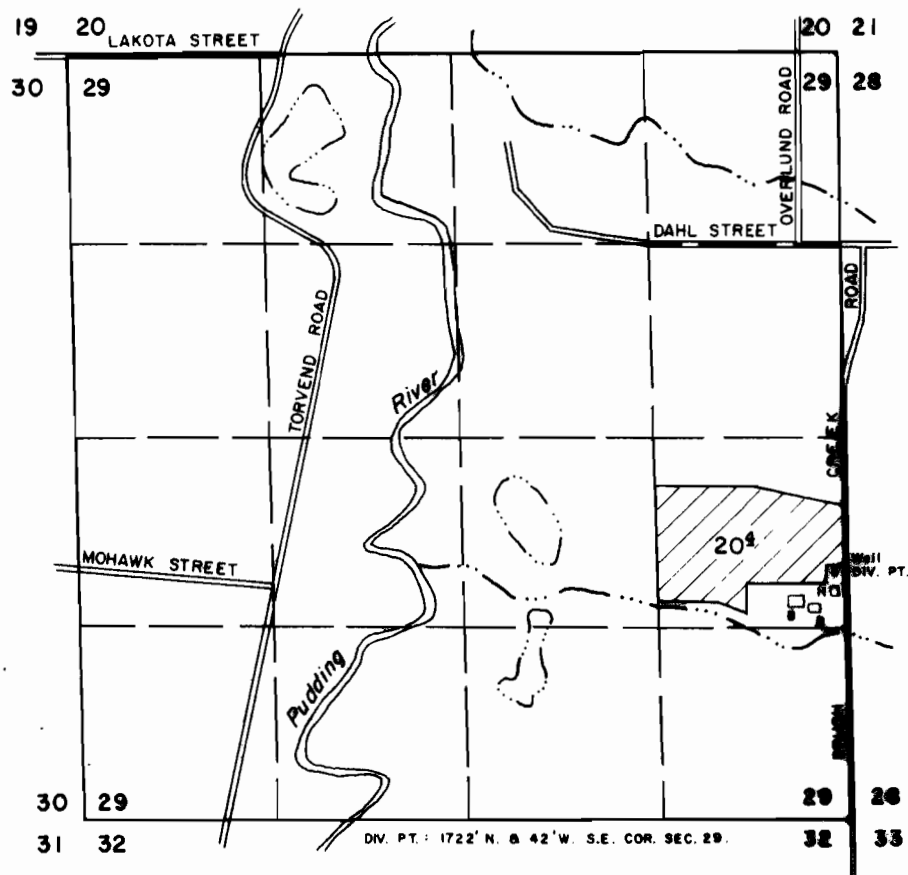

RECEIVED

FEB 07 1996

**FINAL PROOF SURVEY
UNDER**

**WATER RESOURCES DEPT.
SALEM, OREGON**

Application No. G-12689

Permit No. G-11619

**IN THE NAME OF
MALLORIE'S DAIRY, INC.**

JANUARY 16, 1996

Scale: 1" = 1320'

NOTE: This map is for the purpose of identifying the location of water rights and has no intent to dimension or locate property ownership lines.

