


T 12 S R 34 E WM

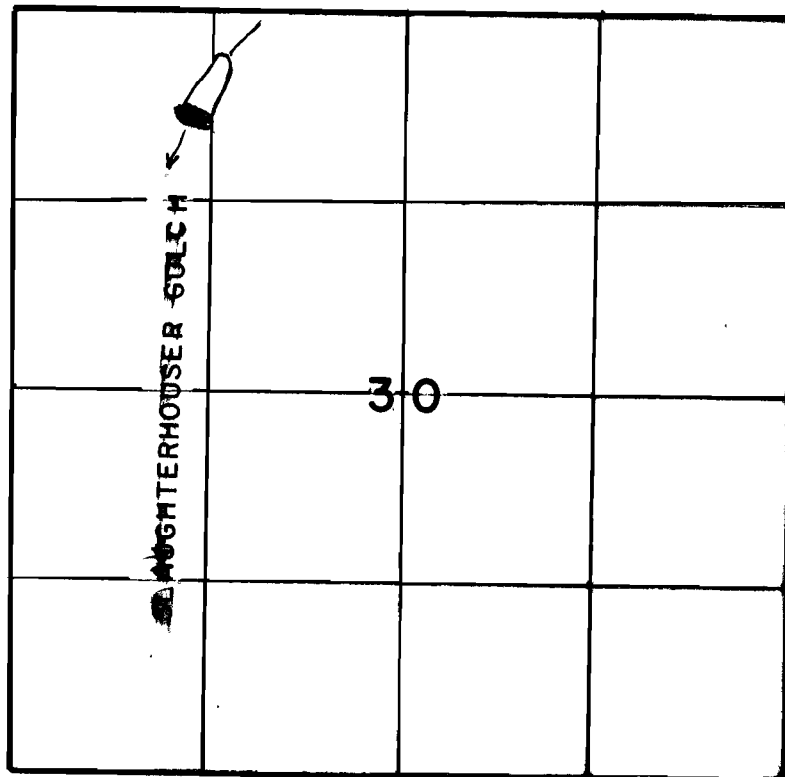

1" = 1320'



FINAL PROOF SURVEY
UNDER

Application No. R-67103 Permit No. R-9267
IN NAME OF

EMMEL BROTHERS

Surveyed OCT 20 1998., by J. MILLER....
SEP 26 2008 L NUNN