


CLAIM OF BENEFICIAL USE

APPLICATION No. S-72392 PERMIT No. 52957


TAX LOT No. 9 41 2600 & 4600; 9 42 3100; and 10 42 800
BAKER COUNTY

FOR:

Duncan S. Mackenzie &
Elizabeth Harrell-Mackenzie
19265 Chandler Lane
Baker City, OR 97814

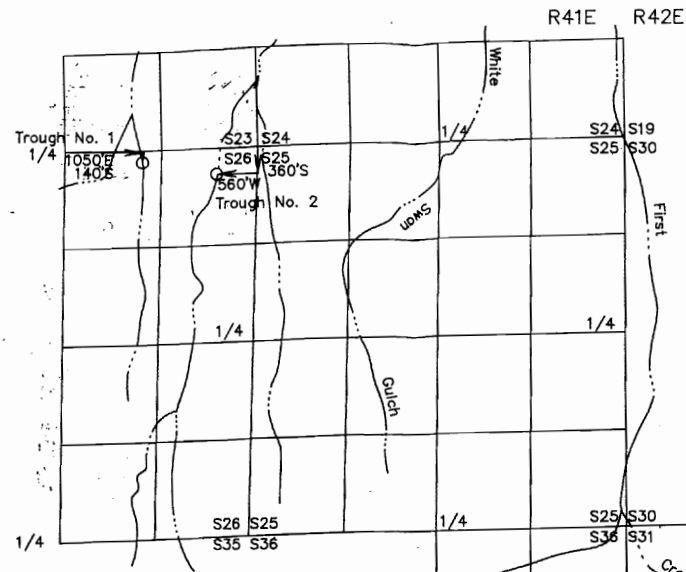

Scale 1" = 2,000'

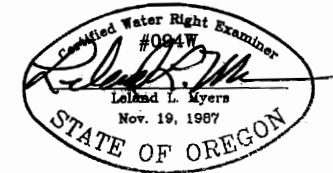

This map is for the purpose of identifying the location of the water right only and has no intent to provide dimensions or location of property ownership lines.

RECEIVED
SEP 9 2000
WATER RESOURCES DEPT.
SALEM, OREGON

