



0392
1042

City of Creswell
Township 19 South,
Ranges 2 & 3 West (W.M.)

- Point of Appropriation (POA)
- Place of Use (POU)
(According to Permit G-10903)
- Tax Lots
- Roads
- Waterbodies
- Watercourses

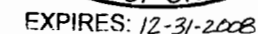


This map was prepared for the purpose of identifying the location of a water right only and it is not intended to provide legal dimensions or location of property ownership lines.

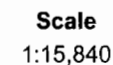

MAP NOTES:
Projection: Oregon State Plane South Zone
Datum: North American Datum of 1983
Date: October 27, 2008
Data Sources: OWRD, Lane County GIS,
Oregon Geospatial Data Clearinghouse, ESRI



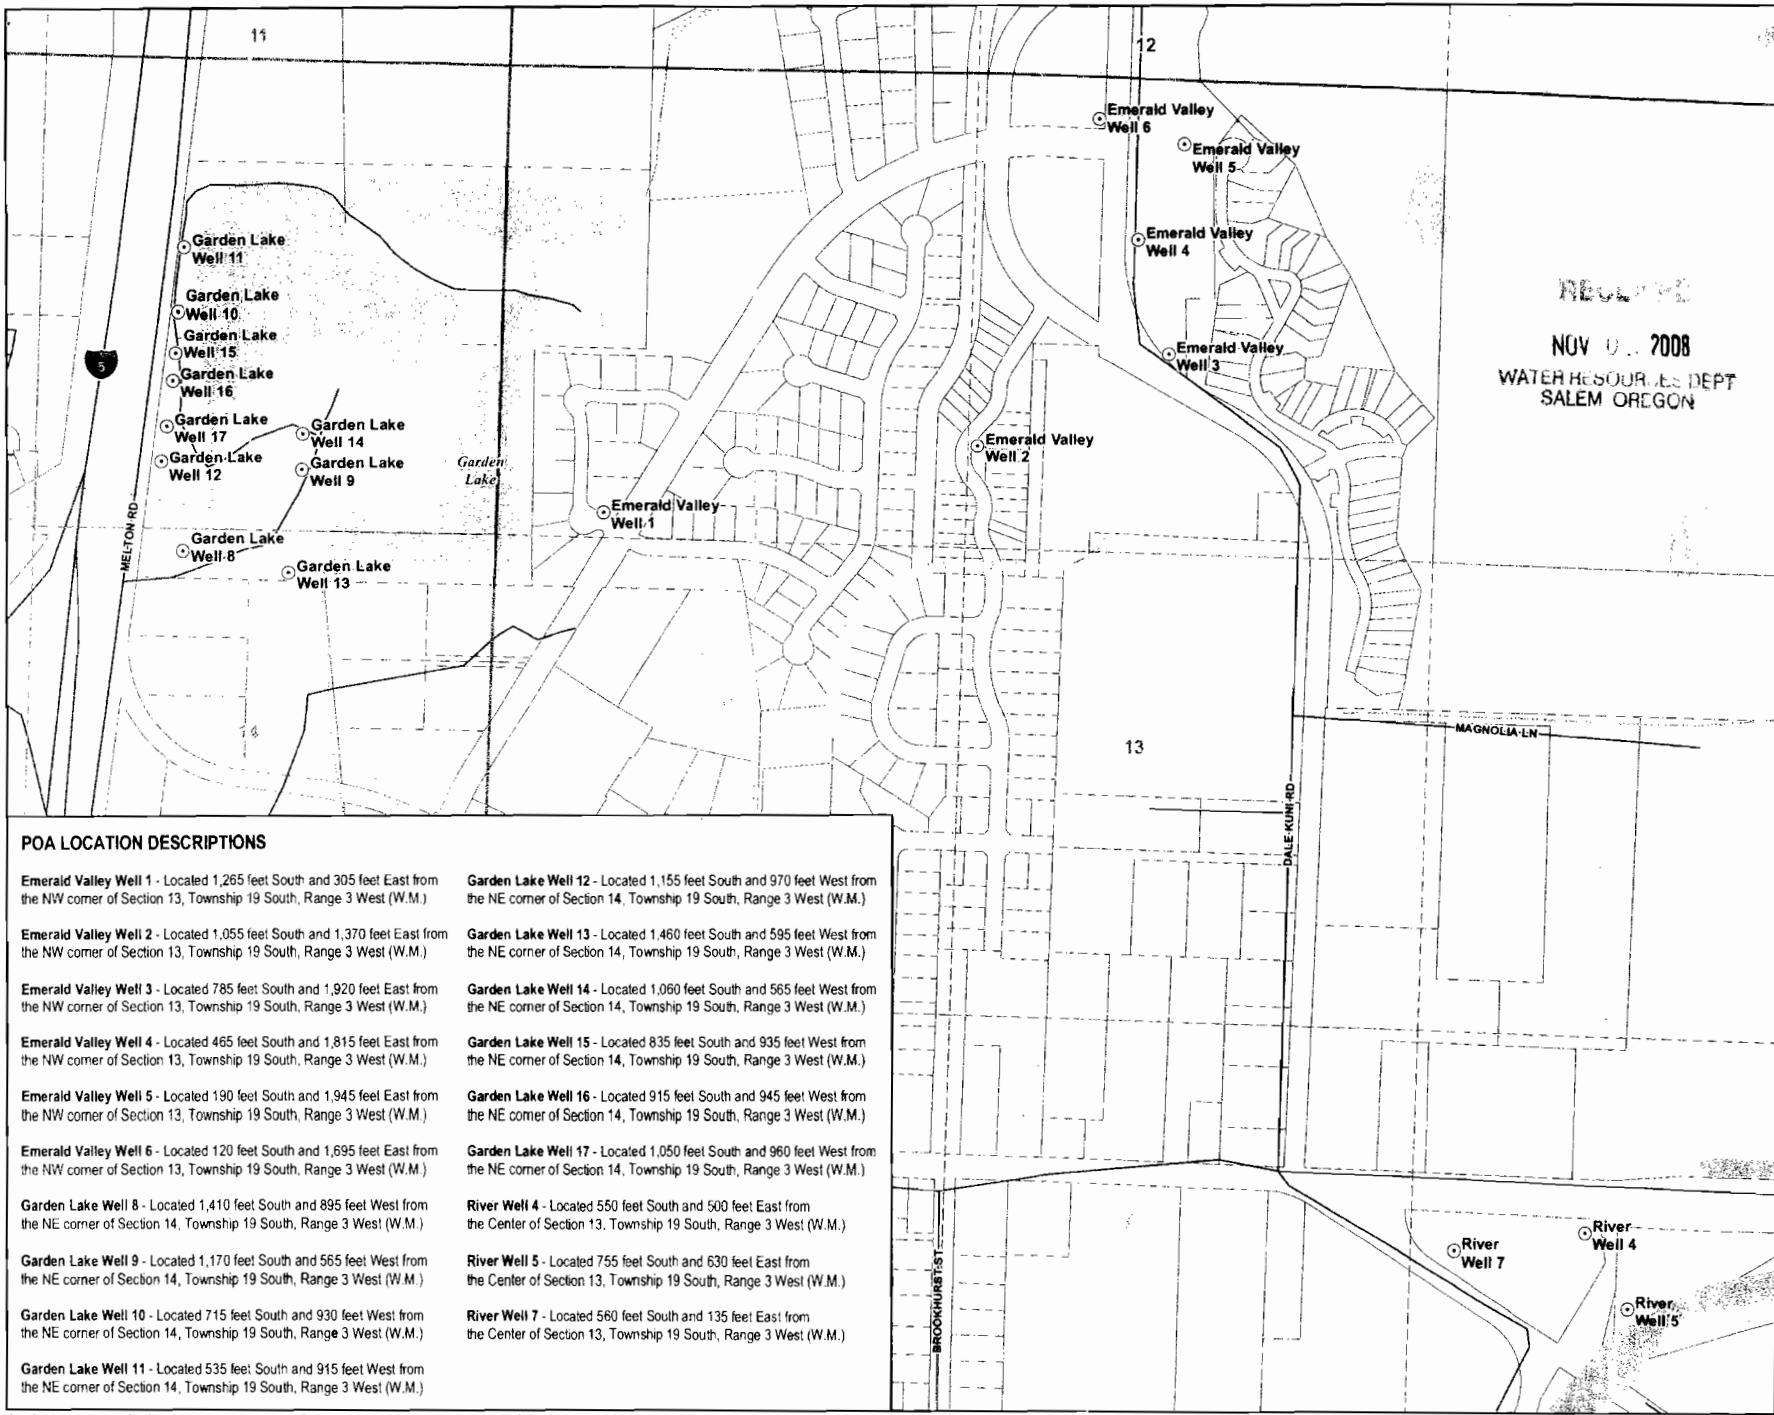

POA LOCATION DESCRIPTIONS	
Emerald Valley Well 1 - Located 1,265 feet South and 305 feet East from the NW corner of Section 13, Township 19 South, Range 3 West (W.M.)	Garden Lake Well 12 - Located 1,155 feet South and 970 feet West from the NE corner of Section 14, Township 19 South, Range 3 West (W.M.)
Emerald Valley Well 2 - Located 1,055 feet South and 1,370 feet East from the NW corner of Section 13, Township 19 South, Range 3 West (W.M.)	Garden Lake Well 13 - Located 1,460 feet South and 595 feet West from the NE corner of Section 14, Township 19 South, Range 3 West (W.M.)
Emerald Valley Well 3 - Located 785 feet South and 1,920 feet East from the NW corner of Section 13, Township 19 South, Range 3 West (W.M.)	Garden Lake Well 14 - Located 1,060 feet South and 565 feet West from the NE corner of Section 14, Township 19 South, Range 3 West (W.M.)
Emerald Valley Well 4 - Located 465 feet South and 1,815 feet East from the NW corner of Section 13, Township 19 South, Range 3 West (W.M.)	Garden Lake Well 15 - Located 835 feet South and 935 feet West from the NE corner of Section 14, Township 19 South, Range 3 West (W.M.)
Emerald Valley Well 5 - Located 190 feet South and 1,945 feet East from the NW corner of Section 13, Township 19 South, Range 3 West (W.M.)	Garden Lake Well 16 - Located 915 feet South and 945 feet West from the NE corner of Section 14, Township 19 South, Range 3 West (W.M.)
Emerald Valley Well 6 - Located 120 feet South and 1,695 feet East from the NW corner of Section 13, Township 19 South, Range 3 West (W.M.)	Garden Lake Well 17 - Located 1,050 feet South and 960 feet West from the NE corner of Section 14, Township 19 South, Range 3 West (W.M.)
Garden Lake Well 8 - Located 1,410 feet South and 895 feet West from the NE corner of Section 14, Township 19 South, Range 3 West (W.M.)	River Well 4 - Located 550 feet South and 500 feet East from the Center of Section 13, Township 19 South, Range 3 West (W.M.)
Garden Lake Well 9 - Located 1,170 feet South and 565 feet West from the NE corner of Section 14, Township 19 South, Range 3 West (W.M.)	River Well 5 - Located 755 feet South and 630 feet East from the Center of Section 13, Township 19 South, Range 3 West (W.M.)
Garden Lake Well 10 - Located 715 feet South and 930 feet West from the NE corner of Section 14, Township 19 South, Range 3 West (W.M.)	River Well 7 - Located 560 feet South and 135 feet East from the Center of Section 13, Township 19 South, Range 3 West (W.M.)
Garden Lake Well 11 - Located 535 feet South and 915 feet West from the NE corner of Section 14, Township 19 South, Range 3 West (W.M.)	


**Claim of Beneficial Use
Point of Appropriation Map**
Permit G-10903 (Application G-11874)

City of Creswell
Township 19 South,
Range 3 West (W.M.)

- LEGEND**
- Point of Appropriation (POA)
 - ⊕ Tax Lots
 - Roads
 - Waterbodies
 - Watercourses

Certified Water Rights Examiner
#78185WRE
Theodore R. Ressler
Theodore R. Ressler
June 29, 2007
STATE OF OREGON
EXPIRES: 12-31-2008

DISCLAIMER
This map was prepared for the purpose of identifying the location of a water right only and it is not intended to provide legal dimensions or location of property ownership lines.

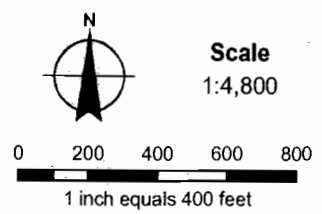

MAP NOTES:
Projection: Oregon State Plane South Zone
Datum: North American Datum of 1983
Date: October 13, 2008
Data Sources: OWRD, Lane County GIS,
Oregon Geospatial Data Clearinghouse, ESRI
GSI
Water Solutions, Inc.

0392

2 of 2