


G-6932

34683

T. 3N., R. 30E., W.M.



SCALE: 1" = 1320'

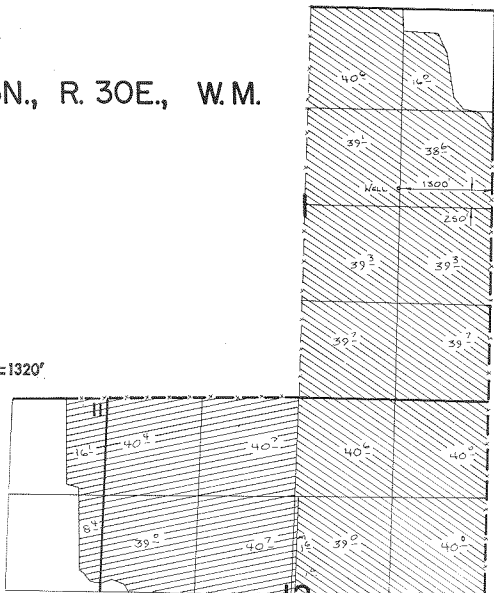

FINAL PROOF SURVEY

UNDER

G-7435

G-6932

Application No. G-10210 Permit No. G-9285
IN NAME OF

...THOMAS E. BRANSTETTER...

Surveyed June 18, 1981, by L. L. Storch
Nov. 5 81

