


CLAIM OF BENEFICIAL USE MAP
IN THE NAME OF
UNITED STATES BUREAU OF LAND MANAGEMENT
MEDFORD DISTRICT

T. 40 S., R. 3 E., W. M.

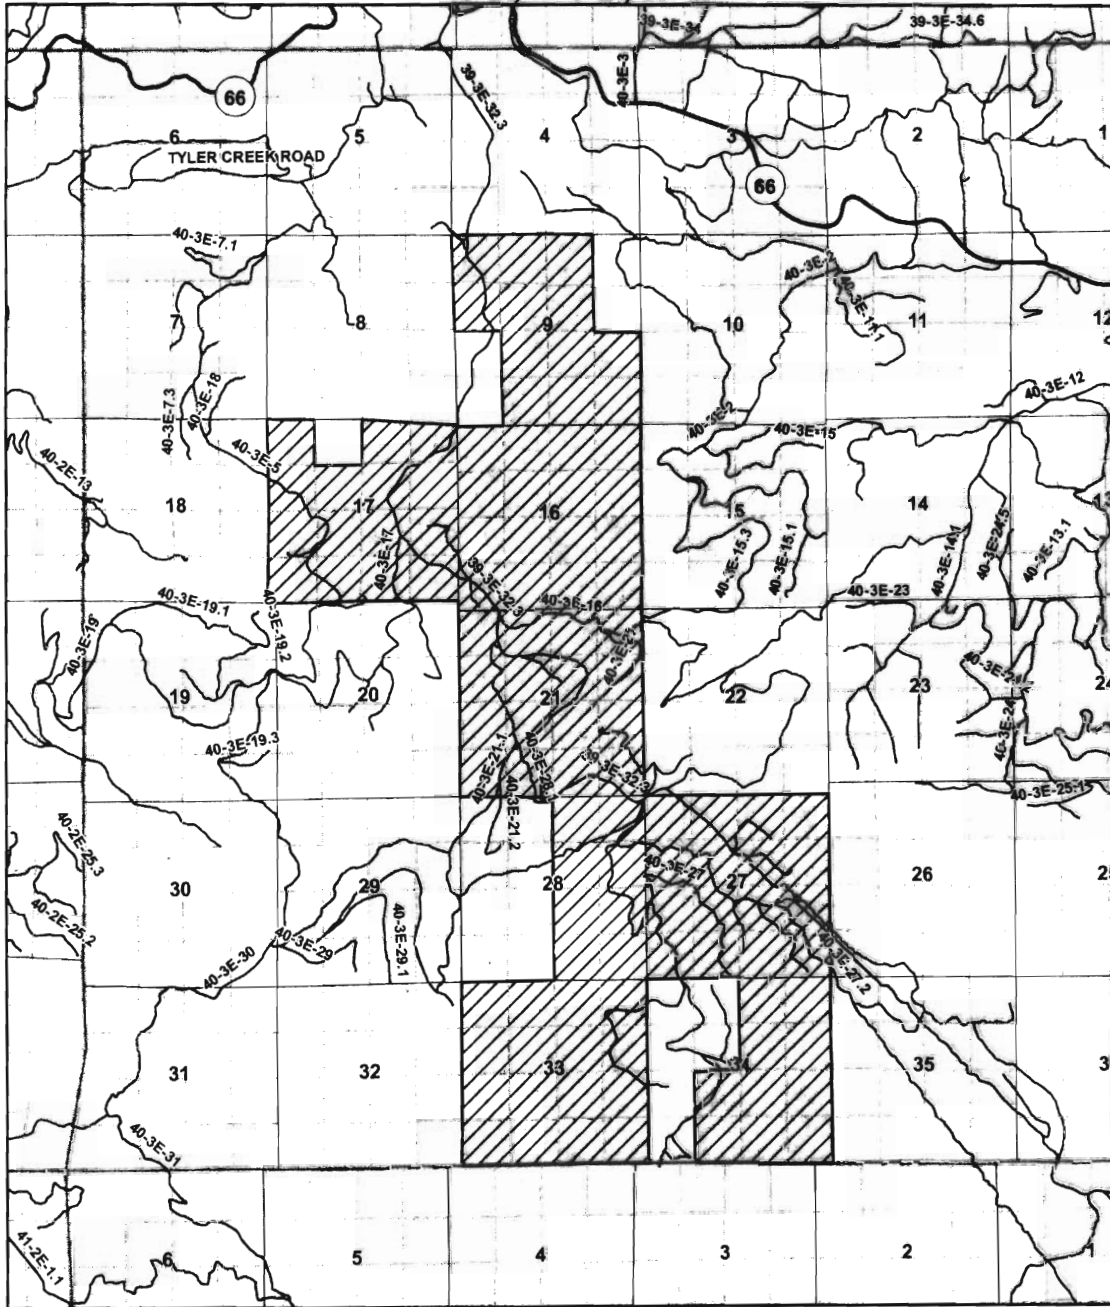


↑
1" = 1 MILE

APPLICATION NO. S-83933 PERMIT NO. 53565

- Legend**
- ROADS
 - PLACE OF USE
 - OWNERSHIP**
 - BLM
 - OTHER

RECEIVED
 MAY 14 2010
 WATER RESOURCES DEPT
 BUREAU OF LAND MANAGEMENT

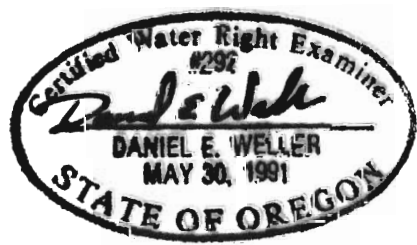

EXPIRES JUNE 30, 2010

THIS MAP IS NOT INTENDED TO PROVIDE LEGAL DIMENSIONS OR LOCATIONS OF PROPERTY OWNERSHIP LINES.