


SECTION 25, 26, 35 & 36, T.2 S., R.4 W., W.M.
YAMHILL COUNTY, OREGON

SCALE: 1"=400'
MAP BASE:
ASSESSORS MAP
2001 COLOR PHOTO

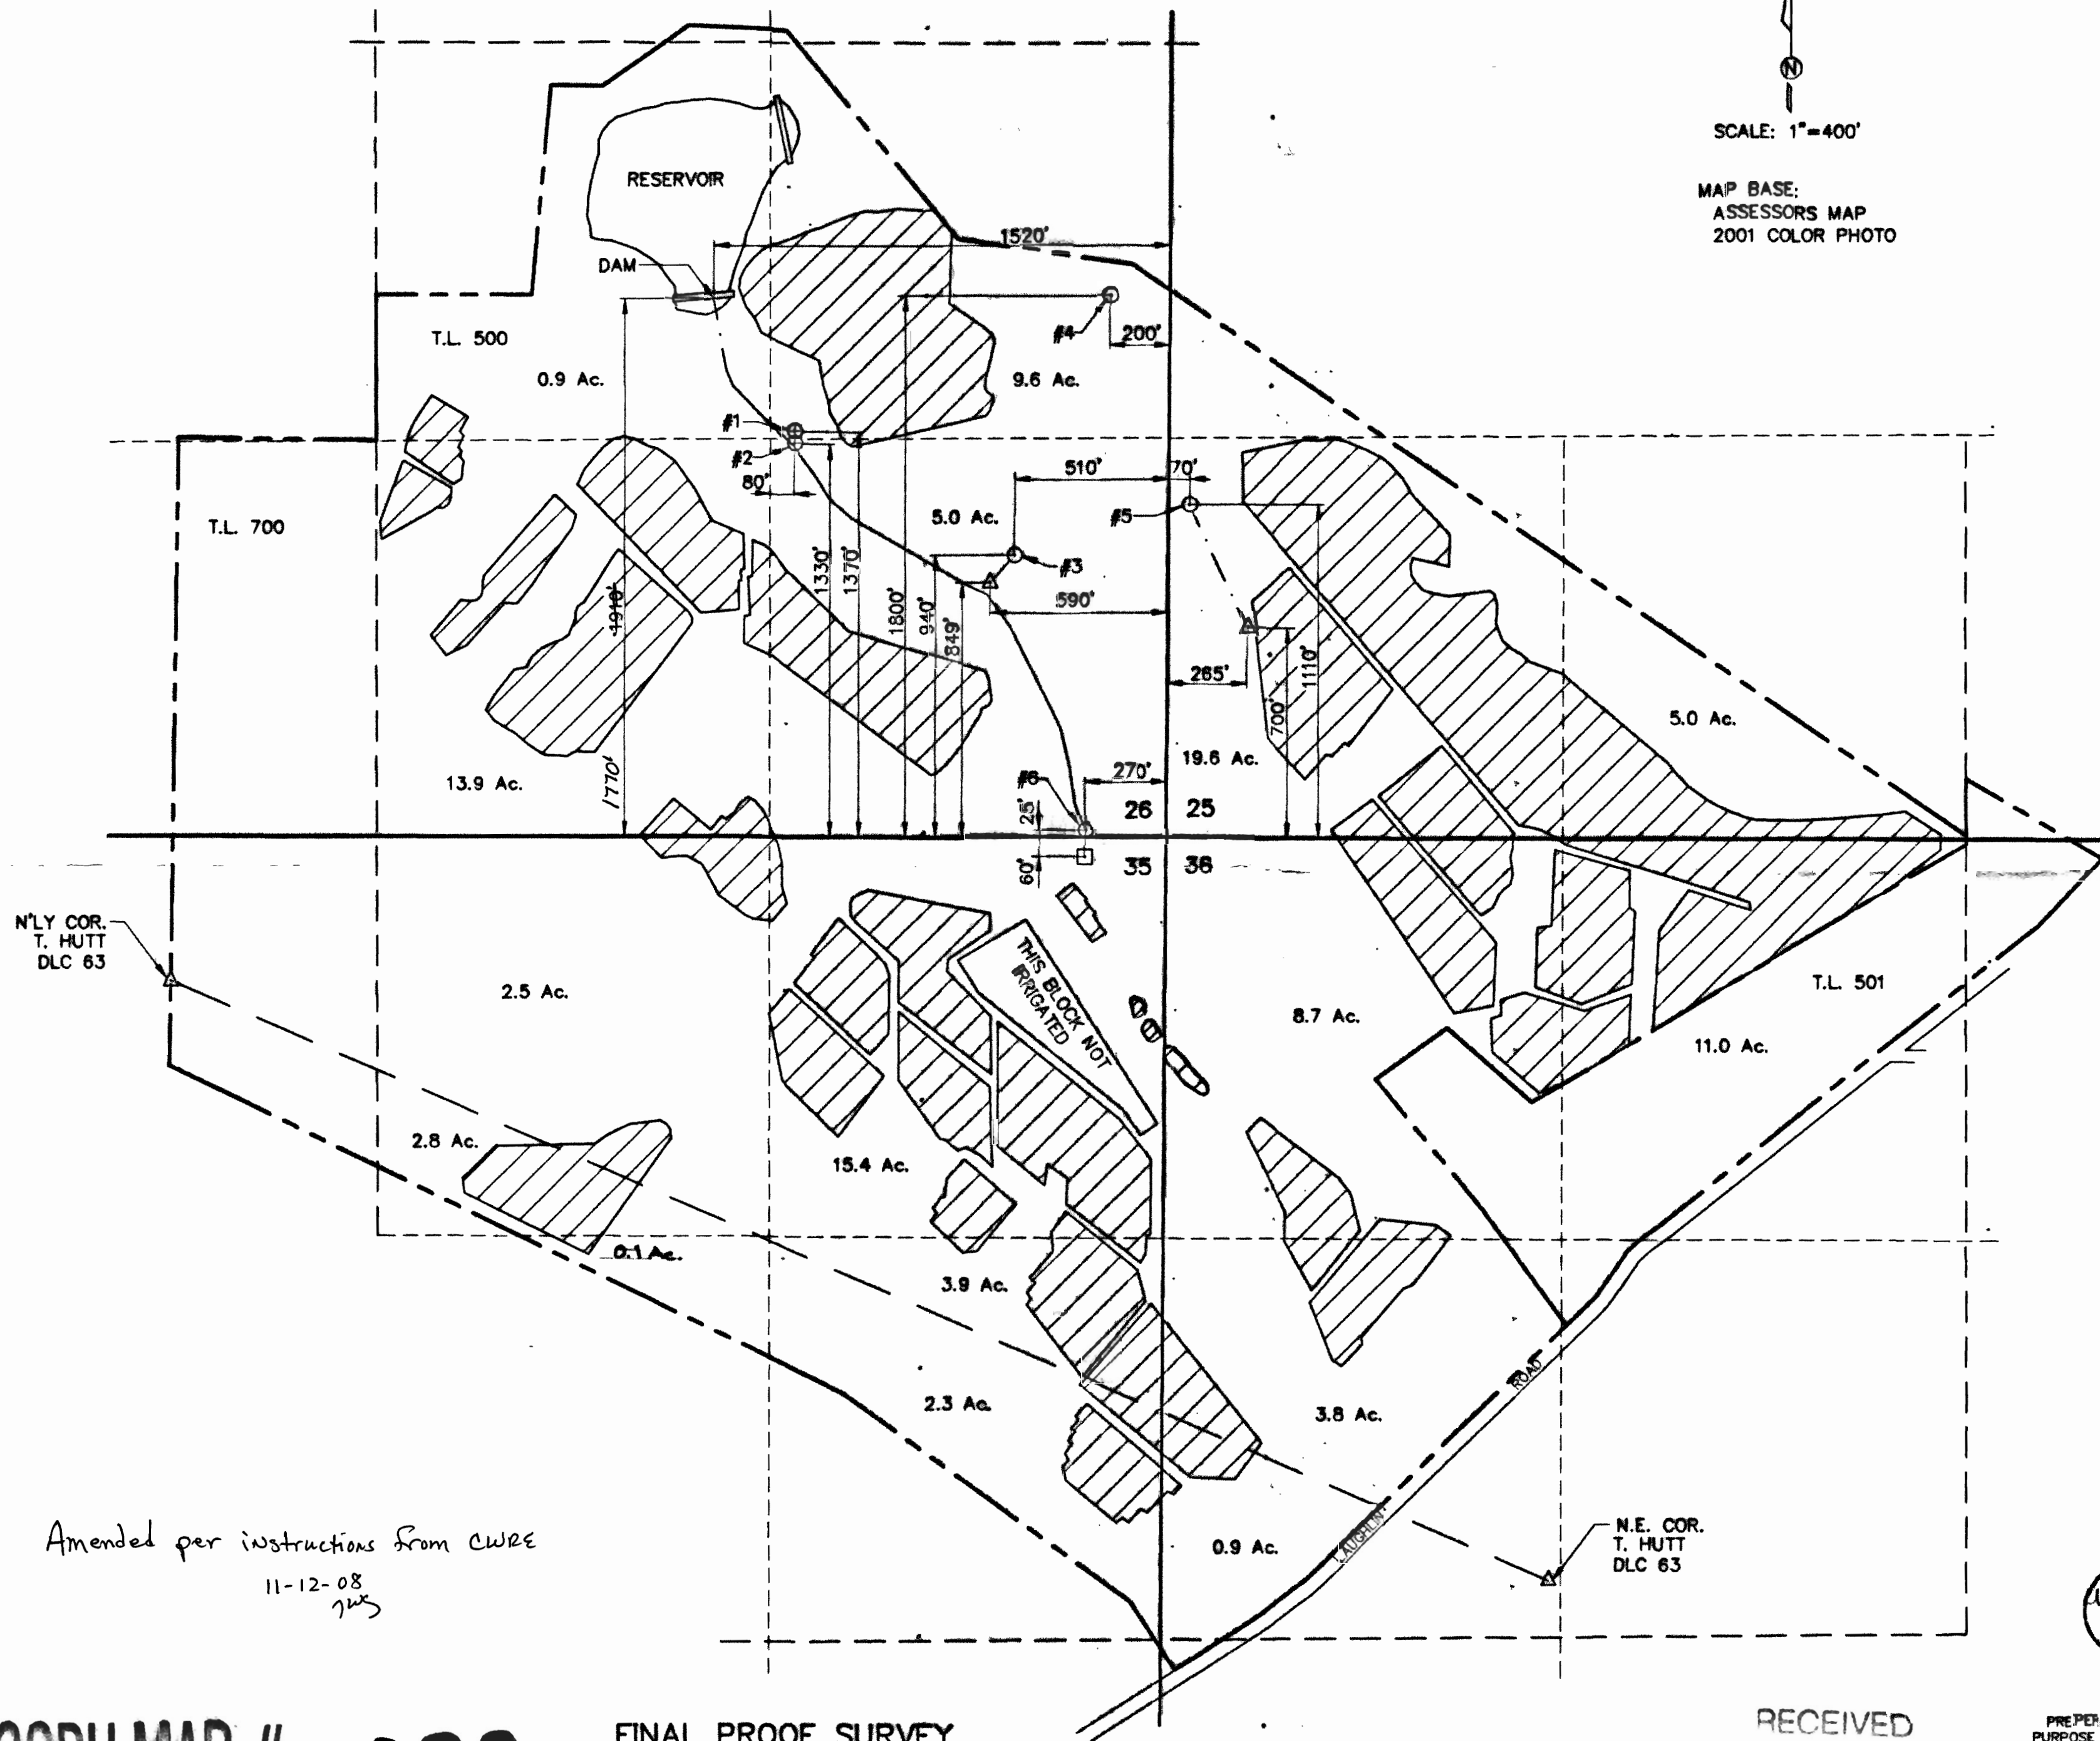

BERNARD J. & RONNI S. LACROUTE
19143 N.E. LAUGHLIN RD
YAMHILL, OR 97148

date	by	designed	drawn	checked	drawing no.	sheet no.
04/23/02	WRV				02-C-01	1
04/23/02	JER					1
04/23/02	WRV					1

LEGEND
○ SPRING
□ PUMP HOUSE
△ STOCK WATER TROUGH

VERBOORT ENGINEERING
AGRICULTURE · CIVIL · WATER RESOURCES
HILLSBORO, OREGON



RECEIVED
MAY 08 2002

PREPARATION OF THIS MAP IS FOR THE PURPOSE OF IDENTIFYING THE LOCATION OF THE WATER RIGHT ONLY. THERE IS NO INTENT TO PROVIDE DIMENSIONS OR LOCATION OF PROPERTY OWNERSHIP LINES.

COBU MAP #0099

FINAL PROOF SURVEY
SURVEYED MARCH 5, 2002
APPLICATIONS S-71566, S-72253
PERMITS 51282, 51586