

SECTION 26 & 35, T.25., R.4W., W.M.

YAMHILL COUNTY, OREGON

RECEIVED

AUG 12 1996

WATER RESOURCES DEPT  
SALEM, OREGON

DIKE  
POINT OF DIV.  
1770' N & 1520' W FROM  
S.E. COR. SEC. 26

RESERVOIR

1520

T.L. 500

DAM



SCALE: 1" = 400'

MAP BASE:  
ASSESSORS MAP  
1994 SCALED PHOTO

PREPARATION OF THIS MAP IS FOR THE  
PURPOSE OF IDENTIFYING THE LOCATION OF  
THE WATER RIGHT ONLY. THERE IS NO INTENT  
TO PROVIDE DIMENSIONS OR LOCATION OF  
PROPERTY OWNERSHIP LINES.

1770'

4" DIA. PVC  
PIPELINE

80'

26


25

35

36

PUMP HOUSE

290'

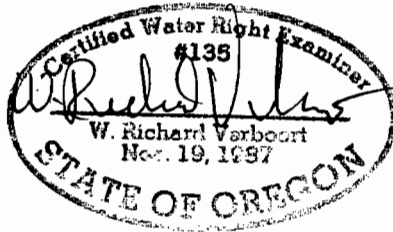

FINAL PROOF SURVEY

SURVEYED JULY 26, 1996

APPLICATION: R-71564 R-73823

PERMITS: R-11400 R-11531

VERBOORT ENGINEERING  
AGRICULTURE • CIVIL • WATER RESOURCES  
HILLSBORO, OREGON

by date  
designed WBY 7.26  
drawn JER 7.26  
checked WRV 7.26  
drawing no. 2-A-02  
sheet no. 1/1

BERNARD J. & RONNI S. LACROUTE  
PROPERTY AT  
19143 LAUGHLIN ROAD NE  
YAMHILL, OR.