


SEC. 6 T.27S. R.4 W. W.M.
DOUGLAS COUNTY

Scale: 1" = 1000'

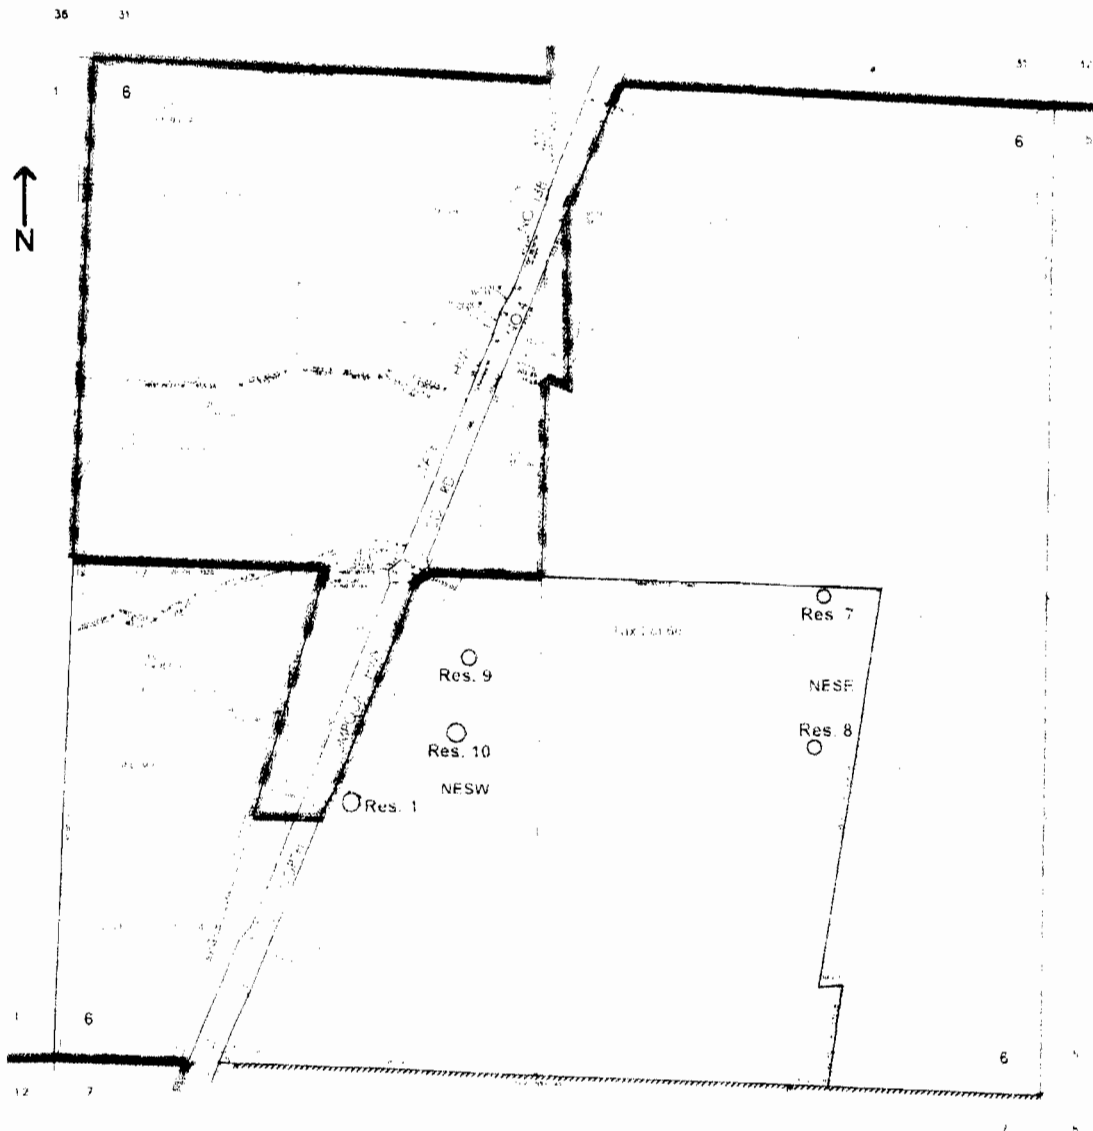

- Res. 1 (Permit R-13448) - 1170 ft. S. and 960 ft. W. }
 Res. 7 (Permit R-13882) - 50 ft. S. and 1470 ft. E. }
 Res. 8 (Permit R-13881) - 830 ft. S. and 1420 ft. E. } all from the center of Sec. 6
 Res. 9 (Permit R-13883) - 450 ft. S. and 370 ft. W. }
 Res. 10 (Permit R-13880) - 830 ft. S. and 420 ft. W. }

RECEIVED

SEP 30 2008

**WATER RESOURCES DEPT
SALEM, OREGON**