


T. 39 S., R. 3 E., W.M.

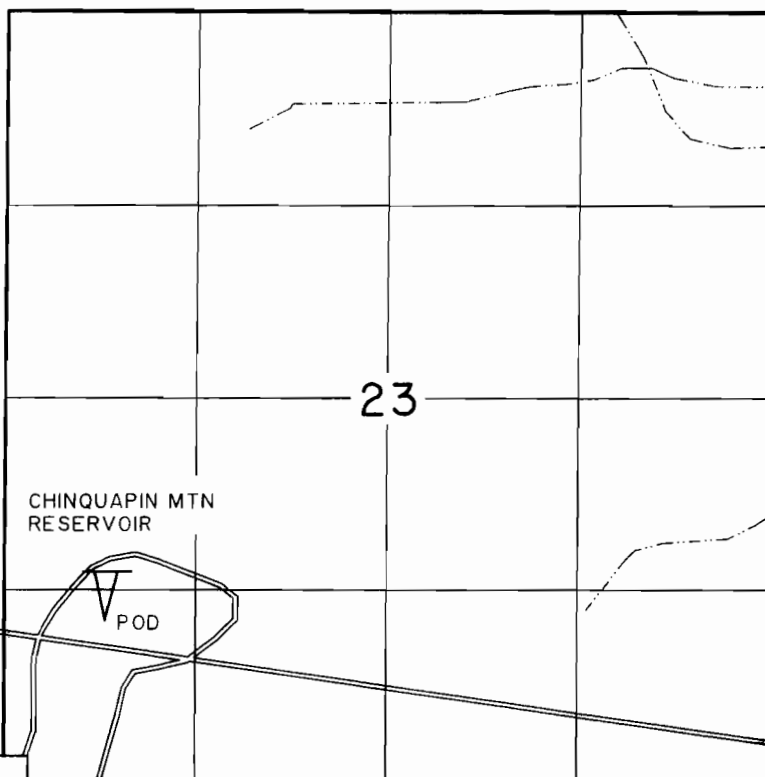

DIVERSION IS LOCATED
710 FT. EAST AND
1445 FT. NORTH OF THE
SW COR OF SECTION 23



1" = 1320'


CLAIM OF BENEFICIAL USE MAP

IN NAME OF

UNITED STATES BUREAU OF LAND MANAGEMENT

APPLICATION NO. [REDACTED] AND S-83931

PERMIT NO. R-12654 AND 53564

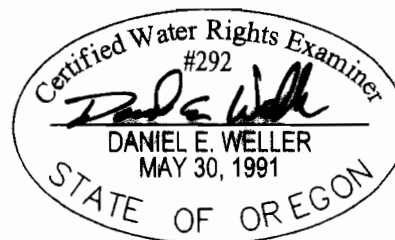

EXPIRES: JUNE 30, 2004

SURVEYED: MAY 9, 2001

THE PURPOSE OF THIS MAP IS FOR IDENTIFYING THE LOCATION OF THE WATER RIGHT ONLY AND IS NOT INTENDED TO PROVIDE LEGAL DIMENSIONS OR LOCATION OF PROPERTY OWNERSHIP LINES.

BLM PROJECT NO.

U.S. BUREAU OF LAND MANAGEMENT-OSO
BRANCH OF CADASTRAL SURVEY
DWG: CHINQUAPIN

EXECUTED BY:

DANIEL E. WELLER, PLS, CWRE #292
P.O. BOX 10226
EUGENE, OREGON 97440