


# T1N, R3E, W.M. SECTION 19

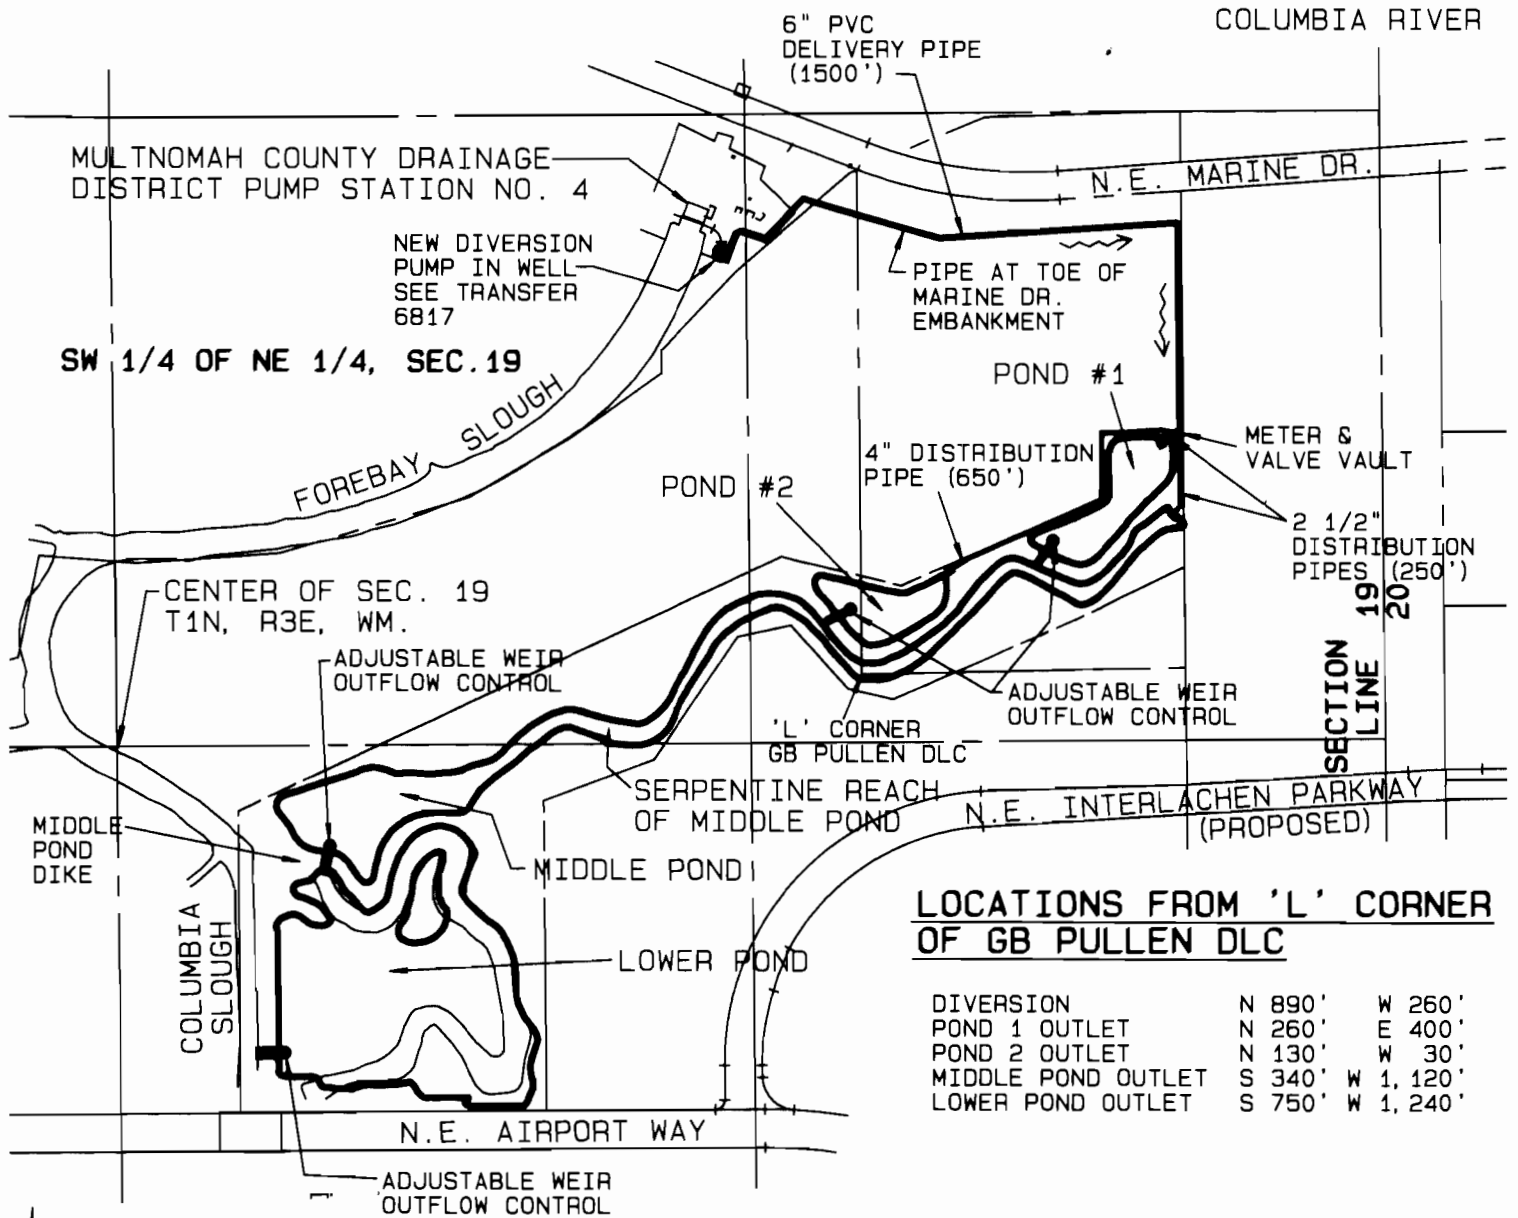

### LOCATIONS FROM 'L' CORNER OF GB PULLEN DLC

DIVERSION	N 890'	W 260'
POND 1 OUTLET	N 260'	E 400'
POND 2 OUTLET	N 130'	W 30'
MIDDLE POND OUTLET	S 340'	W 1,120'
LOWER POND OUTLET	S 750'	W 1,240'


## FINAL PROOF SURVEY

SCALE  
1"=400'

UNDER APPLICATION NO. R-72641 / PERMIT NO. R-11486

IN THE NAME OF:

DONALD COVILLE, CITY OF PORTLAND, AND  
TIM HAYFORD, MULTNOMAH CO. DRAINAGE DISTRICT NO. 1  
SURVEYED NOVEMBER 17, 1995

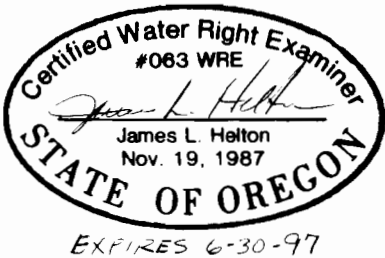

RECEIVED

MAR 28 1996

WATER RESOURCES DEPT.  
STATE OF OREGON

PREPARATION OF THIS MAP WAS FOR THE PURPOSE OF IDENTIFYING THE LOCATION OF THE RESERVOIRS ONLY AND HAS NO INTENT TO PROVIDE DIMENSIONS OR LOCATION OF PROPERTY OWNERSHIP LINES.