

RECEIVED

MAR - 9 1998

WATER RESOURCES DEPT.
SALEM, OREGON


Section 15 Township 30 S Range 12 W W.M.

Coos County
TL 300

FINAL PROOF SURVEY

PREPARED FOR: DONALD L. AND DARLENE W. CASTLEMAN
PREPARED BY: DENNIS GOUDE
SURVEYED: OCTOBER 24, 1997


Application No. S-80618
Permit No. 52677

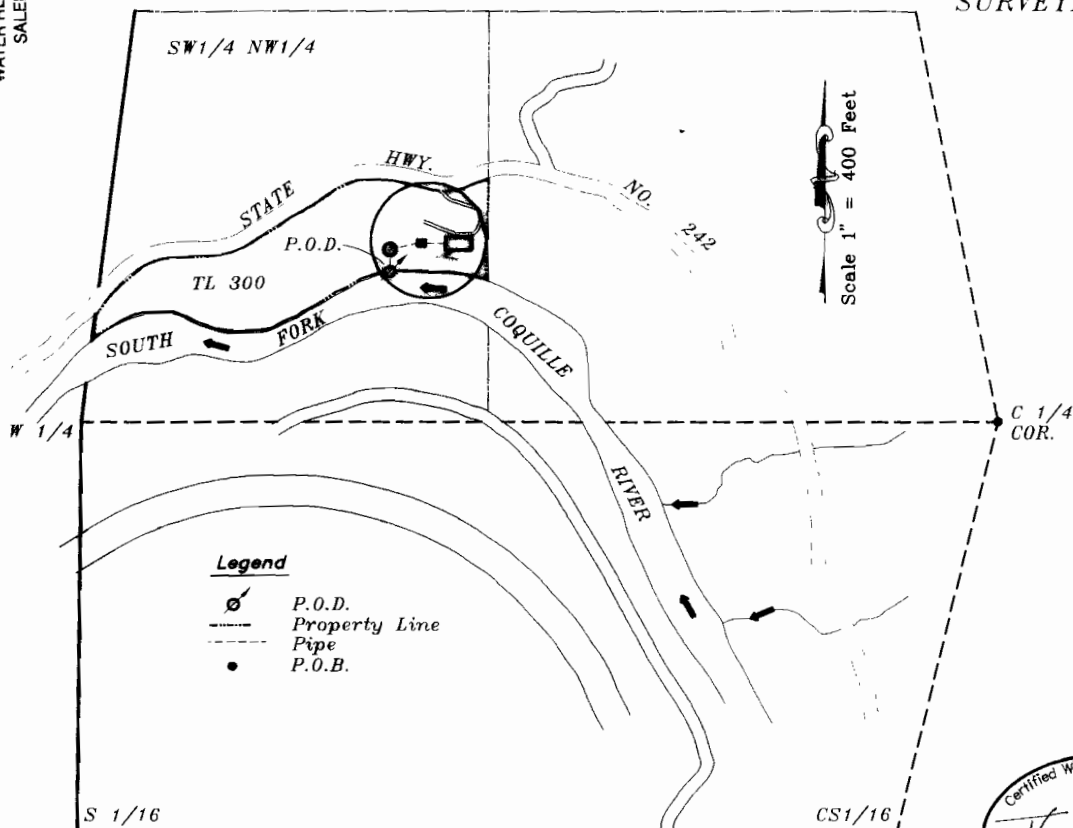

The P.O.D. is located 500 feet north and 1970 feet west from the center 1/4 corner and 1002 feet east and 3140 feet north from the southwest corner of Section 15, Township 30 South, Range 12 West, W.M. The P.O.D. is a 1/2 HP in-stream submersible pump.

NOTE:


The P.O.D. and Waterline is entirely located on property owned by the applicant.

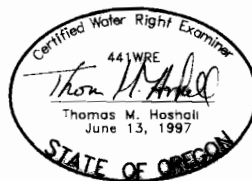

EXPIRES 06/30/99

EXAMINERS DISCLAIMER STATEMENT

The preparation of this map was for the purpose of identifying the location of the Water Right only and has no intent to provide dimensions or location of property ownership lines.

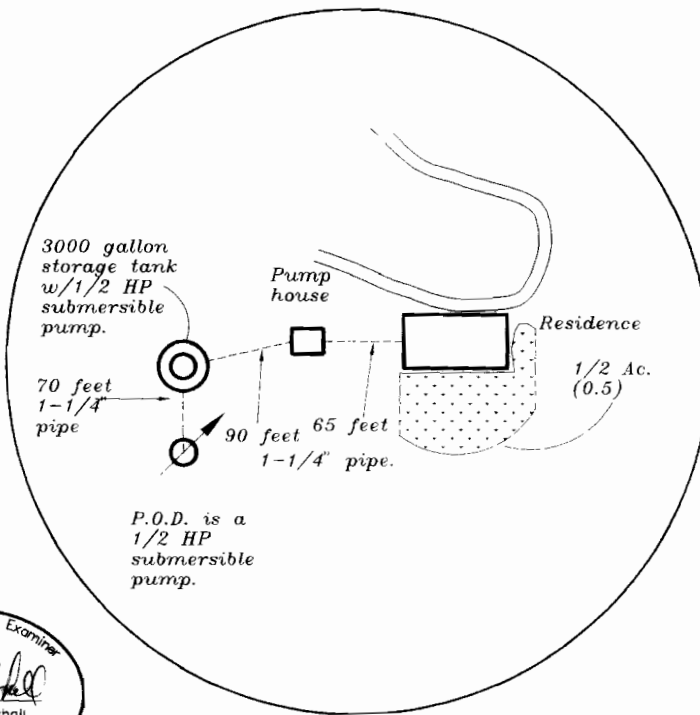

Stuntzner Engineering
& Forestry, LLC

ENGINEERING • LAND SURVEYING • FORESTRY
PLANNING • WATER RIGHTS

705 South 4th St.
Post Office Box 118
Coos Bay, Oregon 97420

Phone (541) 267-2872
Fax (541) 267-0566