


T. 36 S., R. 11 & 12 E., W.M.

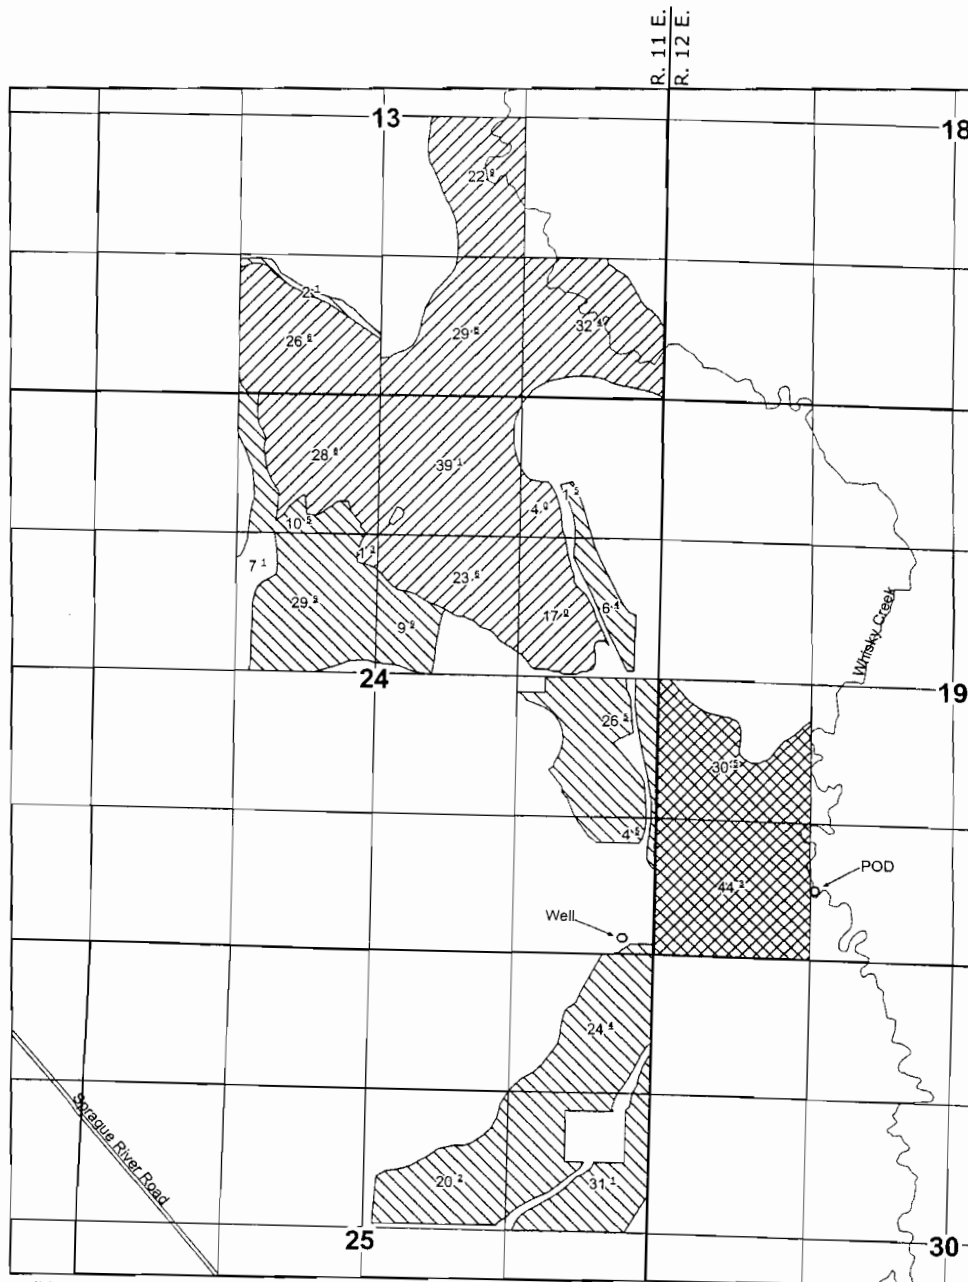

Well located 152' north & 294' west of SE cor. Sec. 24.
 POD located 620' north & 1520' east of SW cor. Sec. 19.

FINAL PROOF SURVEY




 
 
UNDER

58501 44119
 Application No. G-11380 Permit No. G-10498

IN THE NAME OF

Bruce Topham

Surveyed February 2008 by V. CHURCH

-  Primary P# 44119
-  Supplemental P# G-10498
-  Primary P# G-10498
-  Supplemental P# G-10498
-  Overacreage