


RECEIVED

AUG 15 1996

WATER RESOURCES DEPT.
SALEM, OREGON

T.1S., R.4E., W.M.
SECTION 17

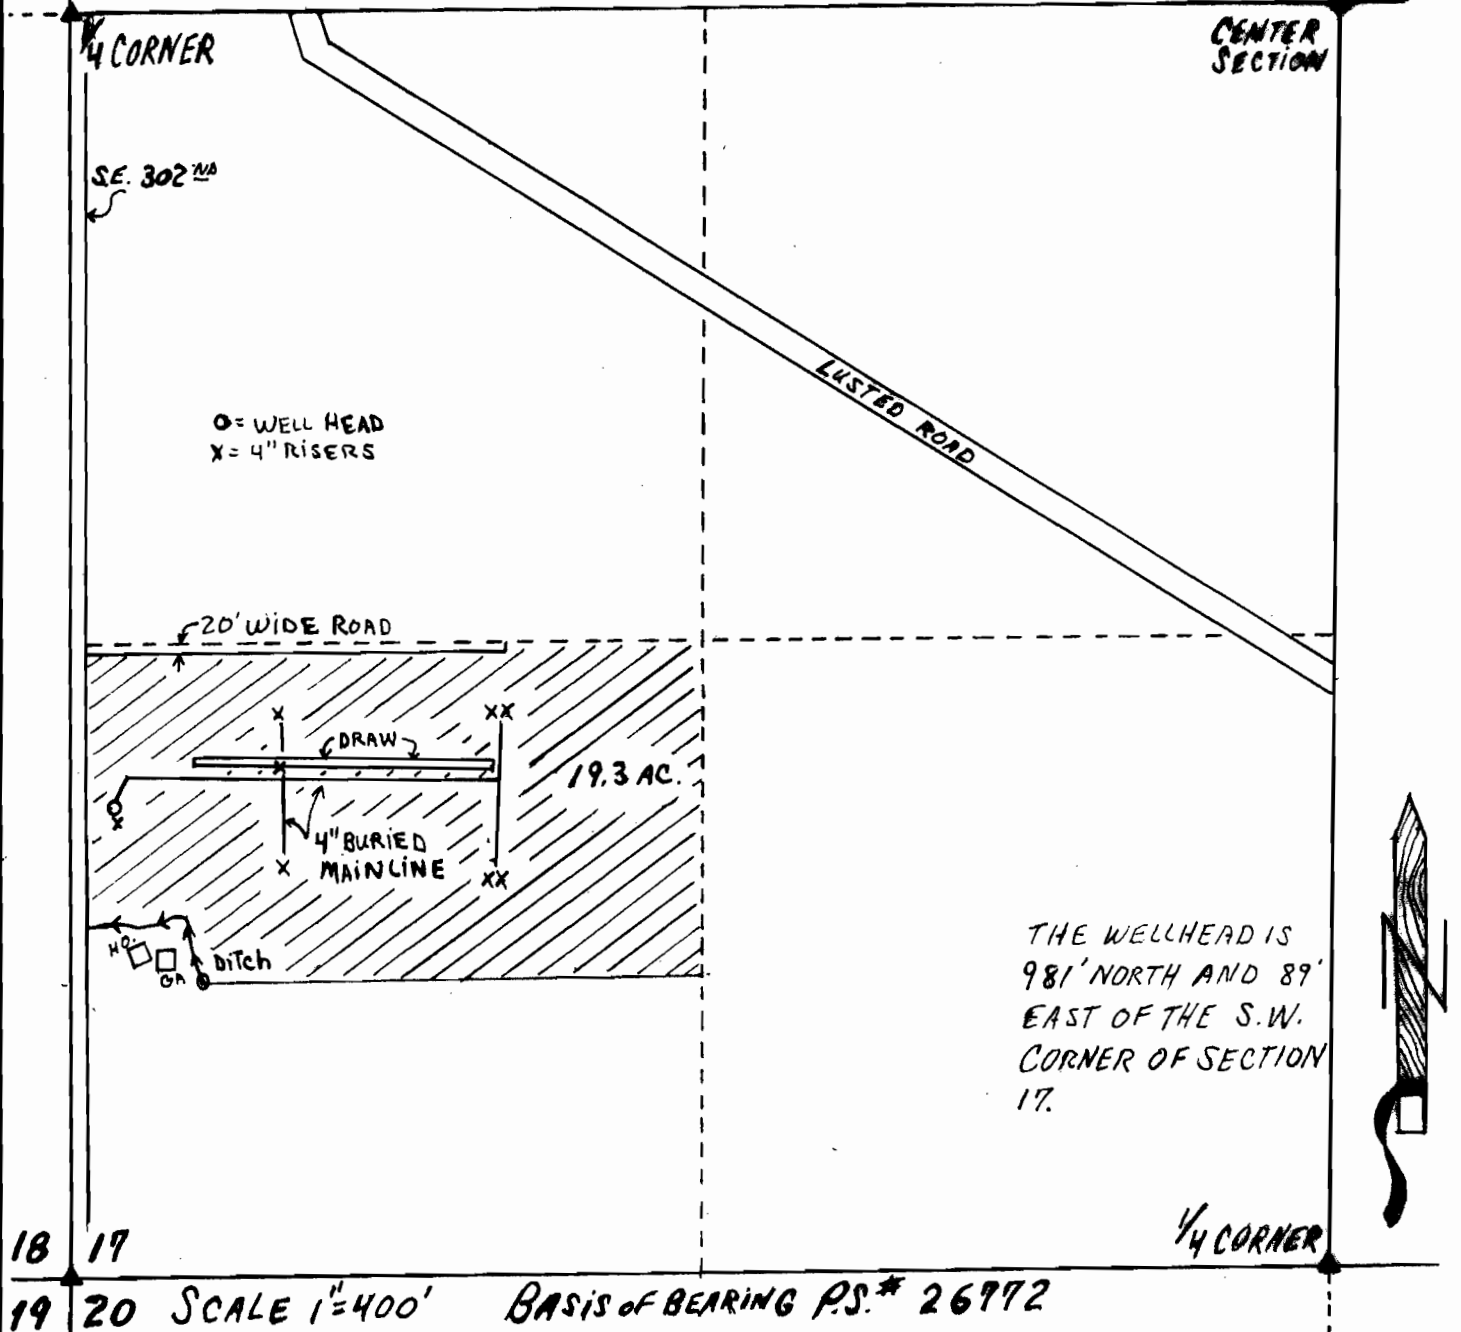

FINAL PROOF SURVEY

UNDER

APPLICATION # G-13150 PERMIT # G-12014
IN THE NAME OF

EKSTROM NURSERY

SURVEYED Aug. 6, 1996 BY PATRICK J. HINDS

