

FINAL PROOF SURVEY

FOR
LEO ALBERTSON
HC 60 BOX 2550
LAKEVIEW, OR 97630
LOCATED IN THE SE1/4 OF THE NE1/4
AND IN THE SW1/4 OF THE NE1/4
OF SECTION 32
TOWNSHIP 40 SOUTH, RANGE 19 EAST, W.M.
LAKE COUNTY, OREGON


LEGEND

- SECTION LINES
- 1/4 SECTION LINES
- 1/16 SECTION LINES
- FOUND LAND SURVEY MONUMENT AS NOTED.
- WELL, LOCATION AS NOTED.
- POINT OF DIVERSION, LOCATION AS NOTED.
- WHEEL LINE
- AREA WHERE GROUND WATER TO BE SUPPLEMENTAL TO CERTIFICATE #38350.
- AREA BEING IRRIGATED NOTED AS PRIMARY GROUND WATER ON PERMIT.

NOTE: PREPARATION OF THIS MAP IS FOR IDENTIFYING PROPOSED WATER RIGHTS ONLY. IT HAS NO INTENT TO PROVIDE LOCATIONS OR DIMENSIONS OF PROPERTY BOUNDARIES.



PREPARED FOR: LEO ALBERTSON HC 60 BOX 2550 LAKEVIEW, OR 97630 (541) 947-2910	
PREPARED BY: ANDERSON ENGINEERING AND SURVEYING INC. P.O. BOX 28 LAKEVIEW, OREGON 97630 (503) 947-4407 FAX 947-2321	
P.O. BOX 419 REDMOND, OREGON 97756 (503) 923-4307 FAX 923-4308	
DATE: 7/10/96	DWG. FILE: 96054
JOB NO.: 96054	SHEET 1 OF 1

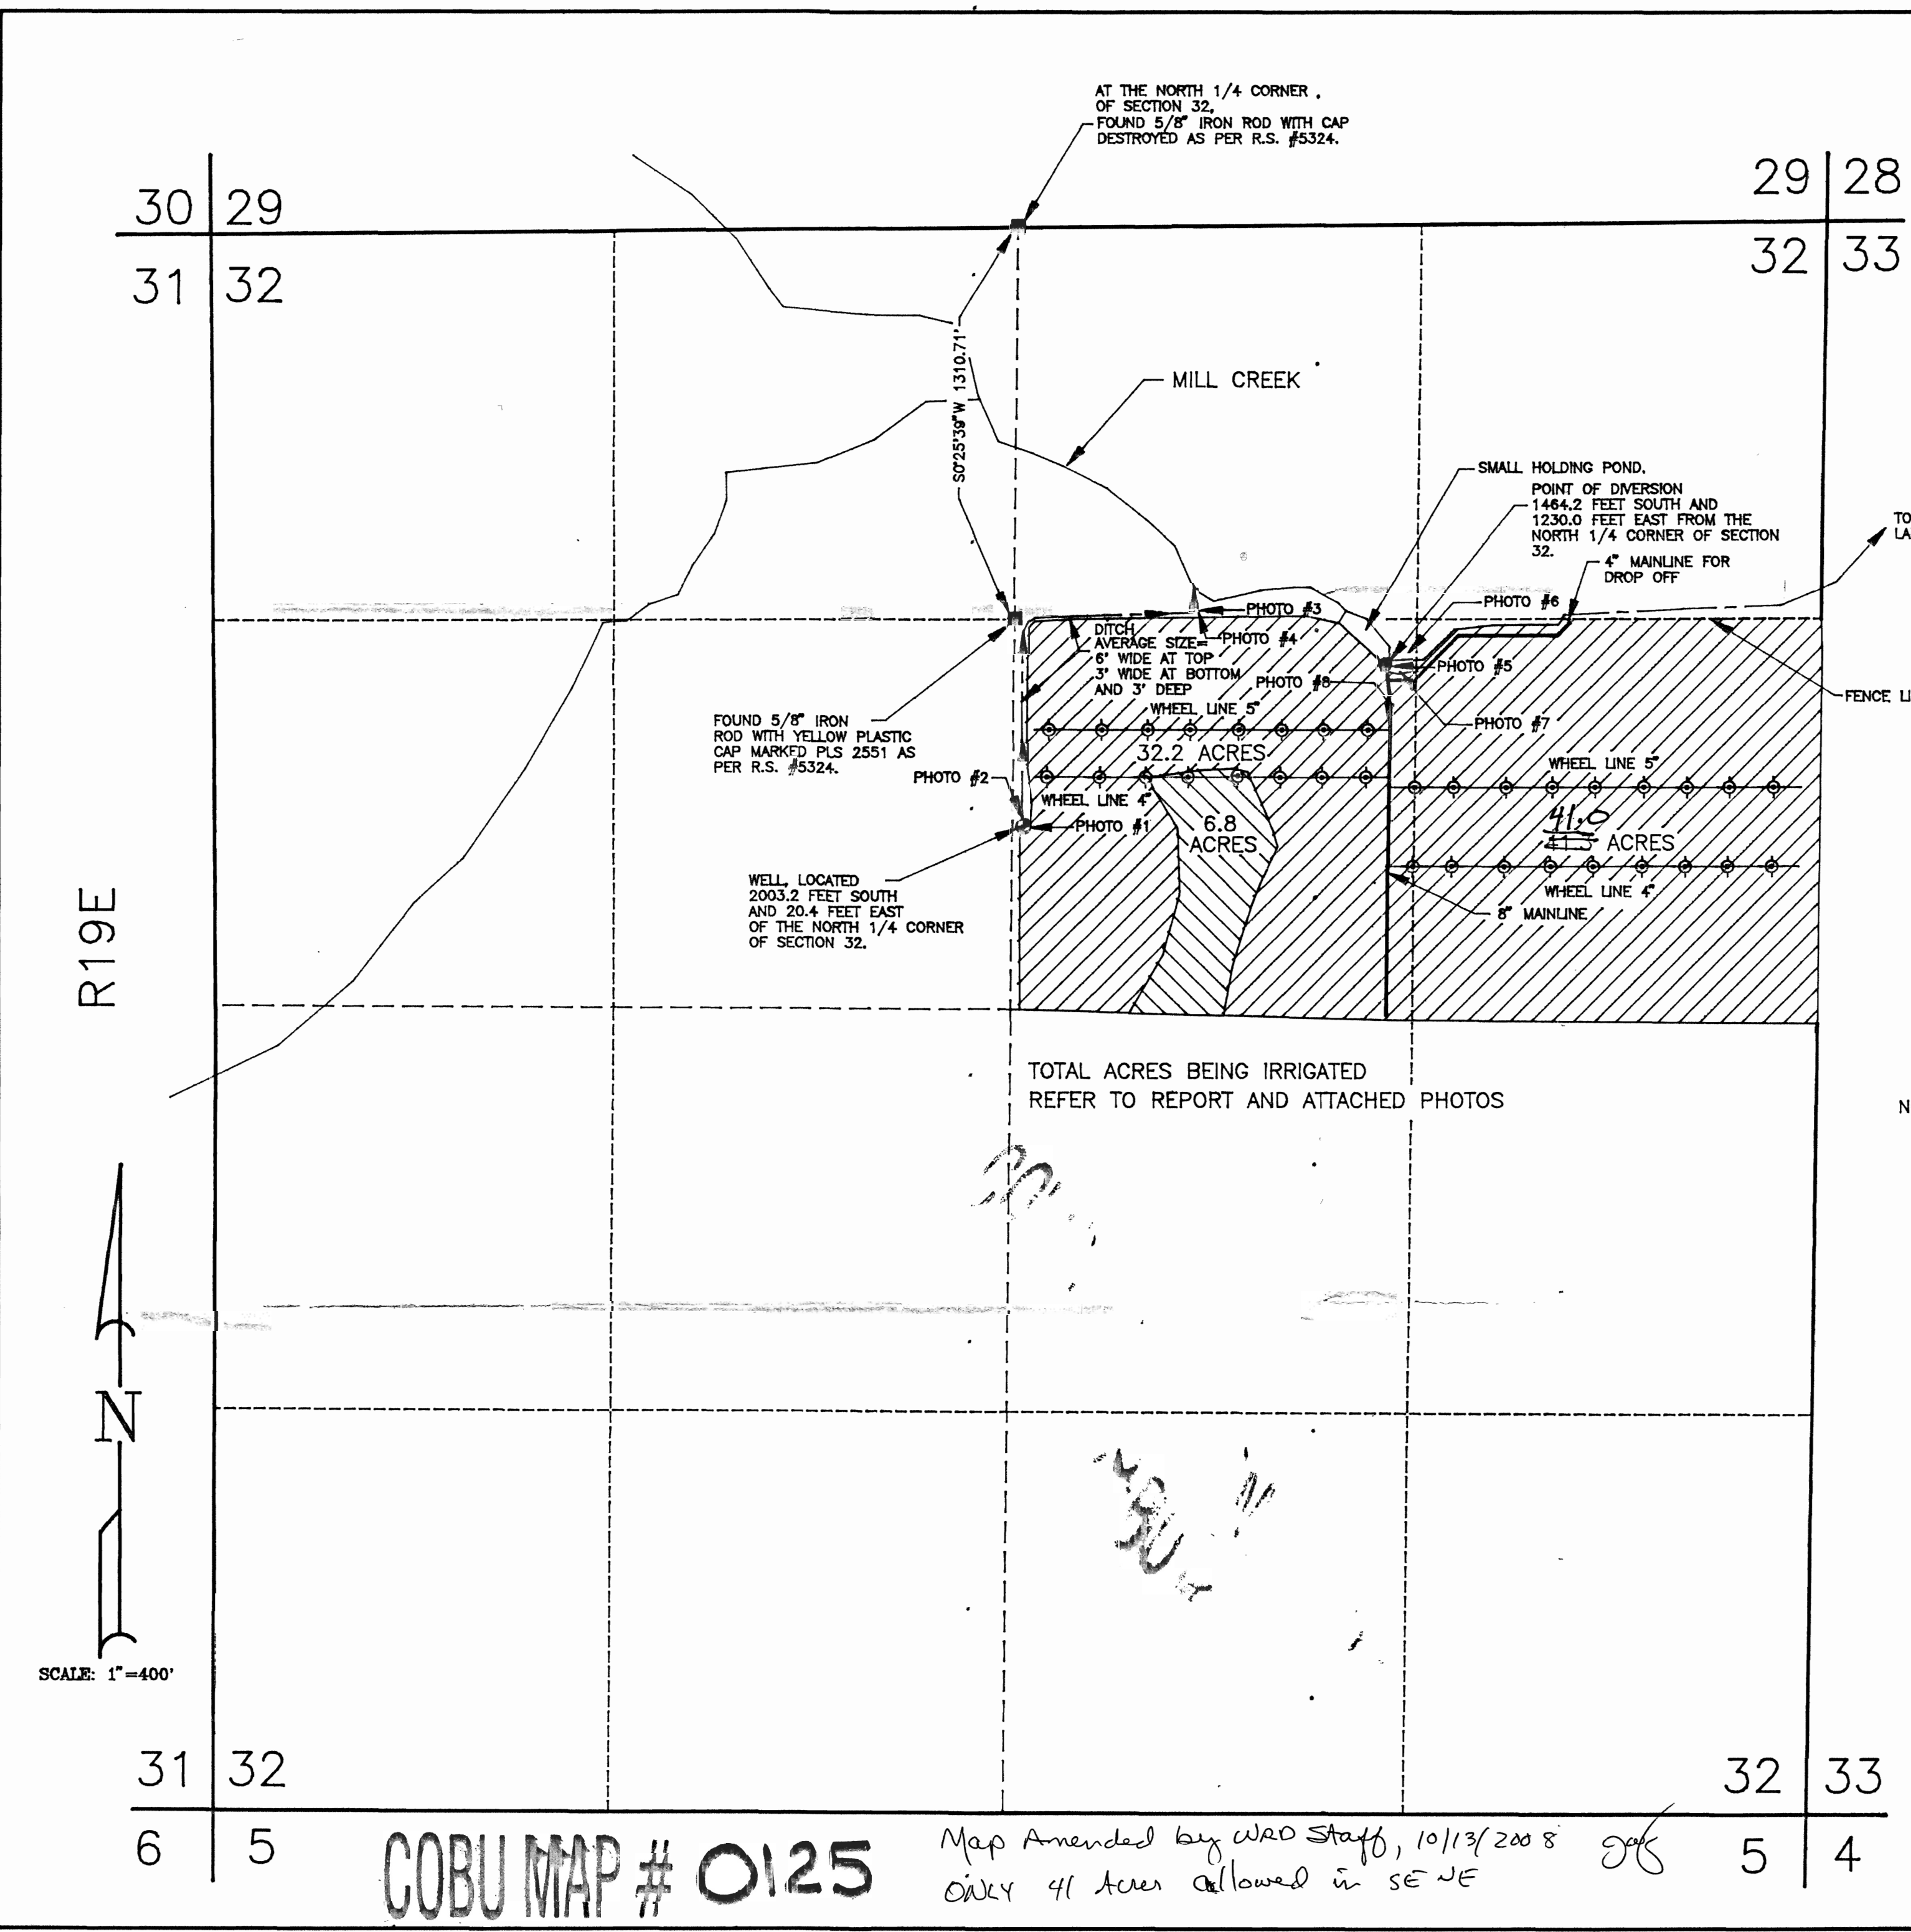

COBU MAP # 0125

Map Amended by WRD Staff, 10/13/2008
Only 41 Acres allowed in SE NE