

FINAL PROOF MAP

IN THE NAME OF

CLARK W. ROEDER & LUCILLE ROEDER SLEWITZKE

LOCATED IN E1/2 NW1/4 & W1/2 NE1/4, SEC. 8, T.33S., R.7 1/2E., W.M.
KLAMATH COUNTY, OREGON

W 1/16
SECS. 6 & 31
ALUM. CAP

N 45°18'09" W
7539.97'



SCALE: 1" = 1320

CRATER LAKE HIGHWAY

WELL
60' S &
60' E FROM
NW CORNER,
NE 1/4,
SEC 8

BUILDINGS & CORRAL

32.9
AC

34.4
AC

40.0
AC

32.8
AC

ANNA CREEK DITCH

8

PERMIT # G11032
APPLICATION # G12045
SUPPLEMENTAL USE TO CERTIFICATE # 1095



AREA IRRIGATED




ACCESS ROAD

THIS MAP IS FOR THE PURPOSE OF
IDENTIFYING THE LOCATION OF THE
WATER RIGHT ONLY AND HAS NO
INTENT TO PROVIDE DIMENSIONS OR
LOCATION OF PROPERTY LINES.

RECEIVED

OCT - 4 1996

WATER RESOURCES DEPT.
SALEM, OREGON

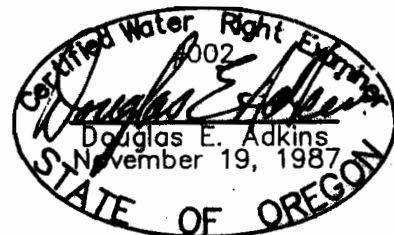

EXPIRES 12/31/97

ADKINS

CONSULTING
ENGINEERS, INC.

Map amended by WRD, Staff - 10-20-08 7028
Engineers ▲ Planners ▲ Surveyors

2950 Shasta Way • Klamath Falls, Oregon 97603 • (541) 884-4666 • FAX (541) 884-5335
Klamath Falls, OR • Medford, OR • Alturas, CA

SEPTEMBER 6, 1996

JOB No. 1359-02