


T. 40 S., R. 11 E., W.M.

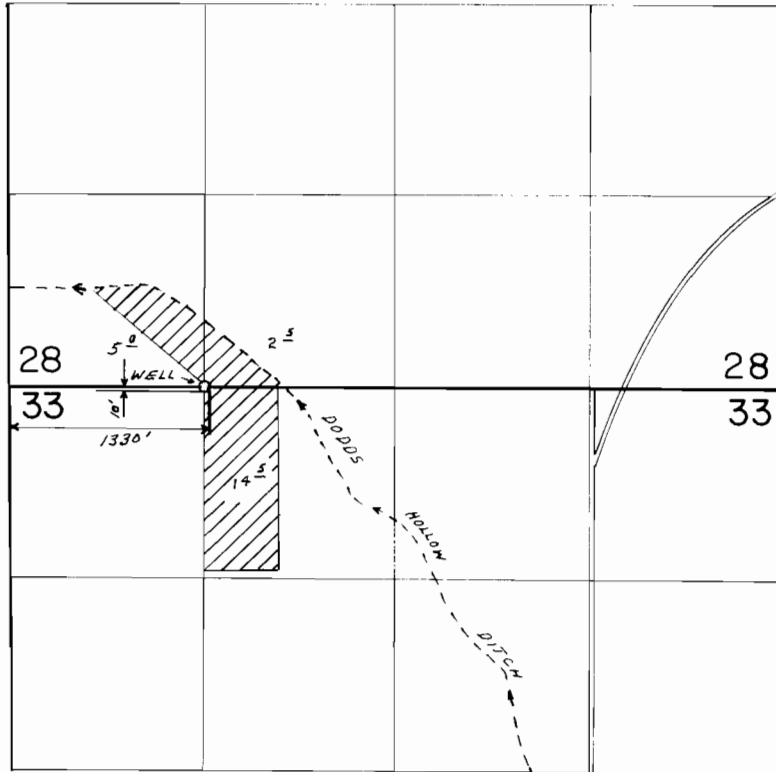

SCALE = 1" = 1320'

FINAL PROOF SURVEY UNDER

Application No. G-11273 Permit No. G-10408.
IN NAME OF

LYNN R. POPE

Surveyed AUG. 18 19. 87, by V. L. CHURCH