


RECEIVED
 JAN 23 2002
 WATER RESOURCES DEPT
 SALEM, OREGON

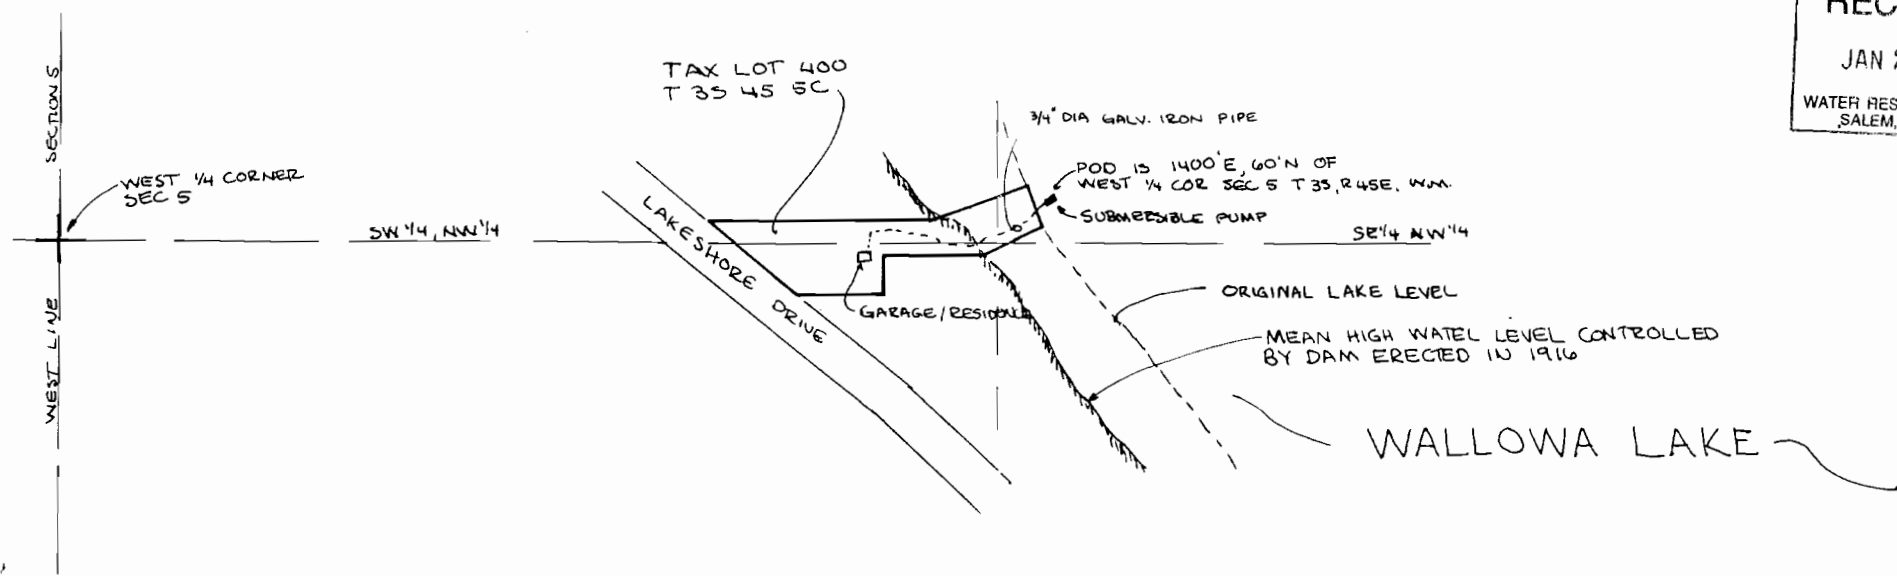

1" = 200'
 IN SECTION 5
 T 35, R 45E, W.M.

THIS MAP IS BASED ON, AND IS THE SAME SCALE AS WALLOWA COUNTY ASSESSOR MAP 35 45 5C

THIS MAP IS PREPARED FOR WATER RIGHT PURPOSES ONLY AND SHOULD NOT BE USED FOR PROPERTY LOCATION PURPOSES.

Certified Water Right Examiner
 230WRE
Ralph W. Swinchart
 Ralph W. Swinchart
 Dec. 7, 1989
 STATE OF OREGON

FINAL PROOF MAP FOR DOMESTIC WATER RIGHT PERMIT #52955
 LYLE & TERA ISAAK, JOSEPH, OREGON

DATE 11/01	WALLOWA MOUNTAIN ENGINEERING PO BOX 266 ENTERPRISE, OREGON 97828 426-4085	REVISIONS	SHEET
JOB 01072			1 OF 1
DESIGN RWS			
DRAWN RWS			