


T.5N. R.29E. W.M.

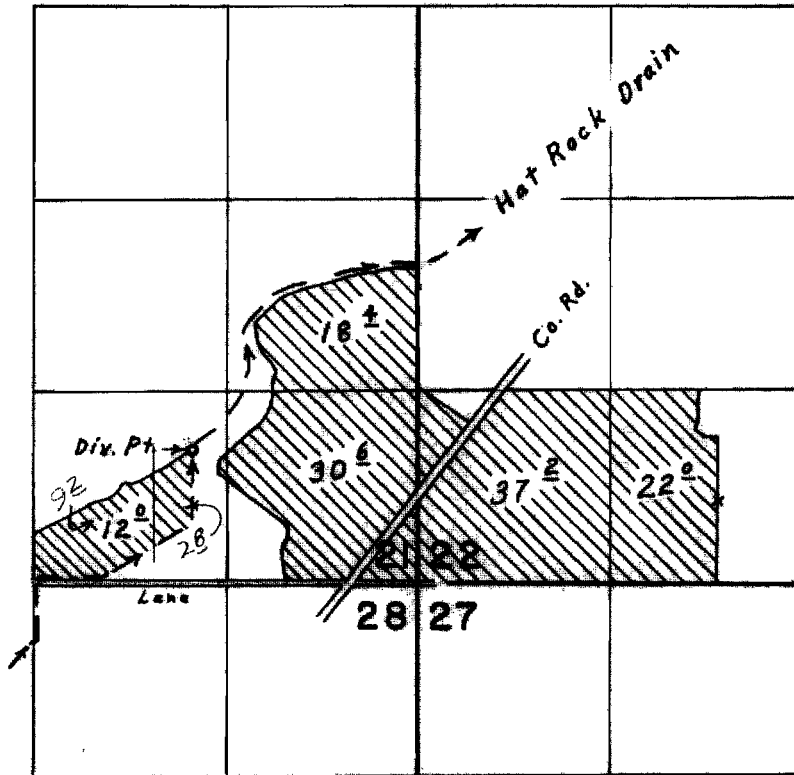

Div. Pt. located 920' N. & 1050' W. from S.E. Cor. Sec. 21

FINAL PROOF SURVEY UNDER

Application No. 42804 Permit No. 32000
IN NAME OF

STANLEY BASFORD

Surveyed April 18, 1973, by L. E. Gould