


T. 8 S. R. 39 E. W.M.

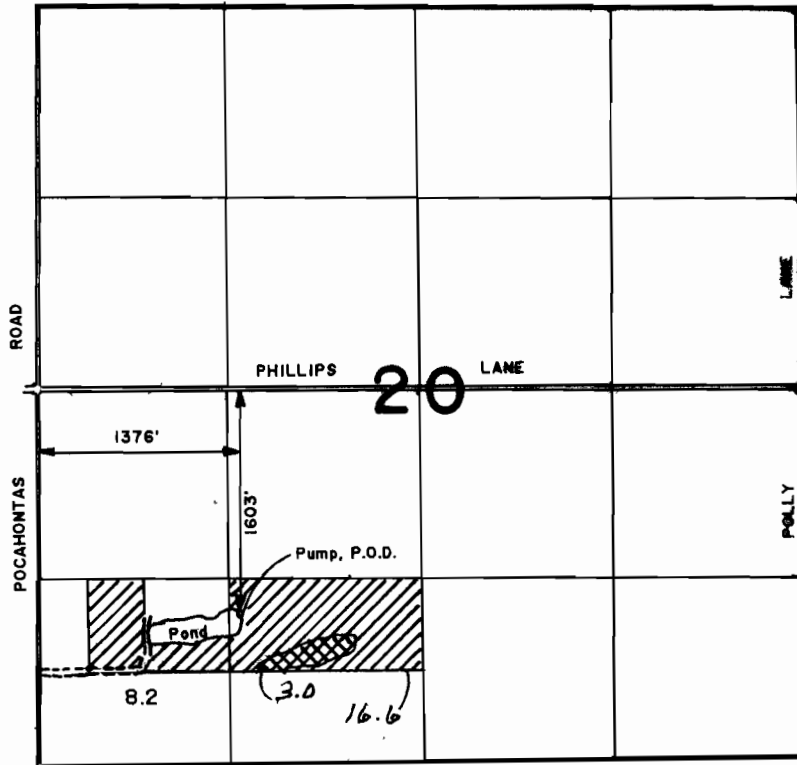

SCALE 1" = 1320'



Primary



Supplemental

The purpose of this map is for identifying the location of the water right only and is not intended to provide legal dimensions of property ownership lines.

FINAL PROOF SURVEY UNDER

Application No. G-12360 Permit No. G-11267

IN NAME OF

FRANK L. and ODETTA MILLER

Surveyed September 22, 1994
AMENDED 11/12/08 WRD-LN to match primary

RECEIVED

SEP 27 1994

WATER RESOURCES
DIVISION

