

RECEIVED


JAN 13 1997  
WATER RESOURCES DEPT.  
SALEM, OREGON

# FINAL PROOF SURVEY


## NE 1/4, NE 1/4, SEC 36, T 2 N, R 10 E, WM COUNTY OF HOOD RIVER, STATE OF OREGON



NORTH

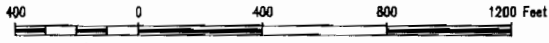

36

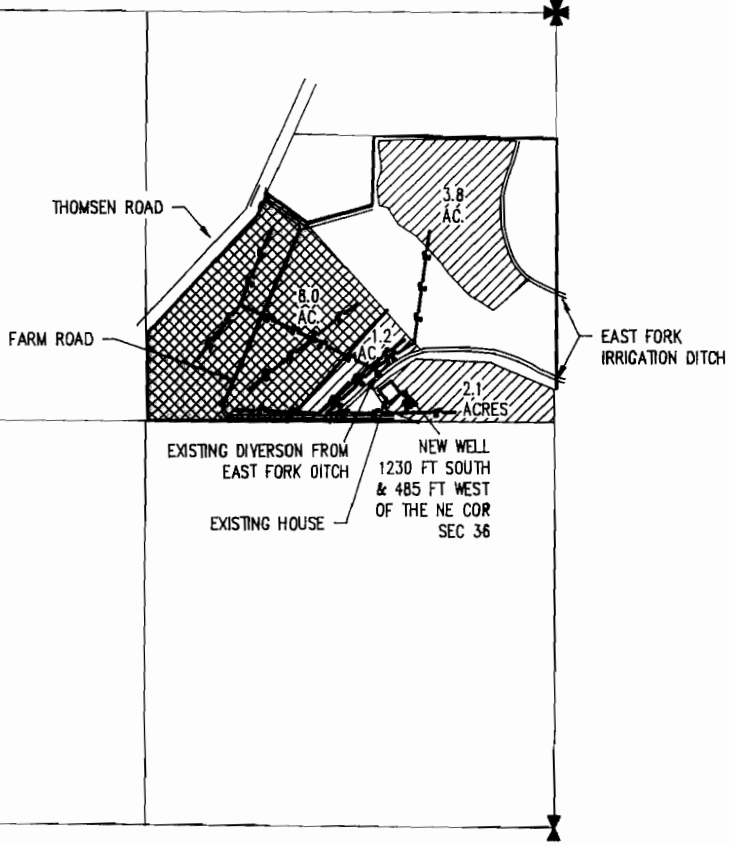

- = 7.1 ACRES ORCHARD IRRIGATION & HOUSE & GARDEN
- = 8 ACRES OF SUPPLEMENTAL ORCHARD IRRIGATION
- = 2" PVC WATER DISTRIBUTION LINES

### TOTAL ACRES IRRIGATED

SUPPLEMENTAL ORCHARD = 8 ACRES  
 PRIMARY ORCHARD, HOUSE & GARDEN = 7.1 ACRES

### CERTIFICATE:

I, ANTHONY C. KLEIN, THE WITHIN REGISTERED WATER RIGHT EXAMINER DO HEREBY CERTIFY THAT THIS MAP WAS PREPARED BY ME AND IS FOR THE PURPOSE OF IDENTIFYING THE LOCATION OF THE WATER RIGHT ONLY AND HAS NO INTENT TO PROVIDE DIMENSIONS OR LOCATION OF PROPERTY OWNERSHIP LINES.

## FINAL PROOF SURVEY UNDER

REFERENCE: FILE G-13839 PERMIT NO.: G-12078  
 IN THE NAME OF

### THOMAS SAWYER



Certified Water Right Examiner  
#201  
*Anthony C. Klein*  
Anthony C. Klein  
Nov. 28, 1988  
STATE OF OREGON

## Klein & Assoc.

LAND SURVEYING  
 1109 Country Club Road  
 Hood River, Oregon 97031  
 Tele: (303)386-3322  
 DATE SURVEYED: July 1996  
 JOB NO.: 9401B