


T 6 S, R 4 W, W.M.

POLK COUNTY, OREGON

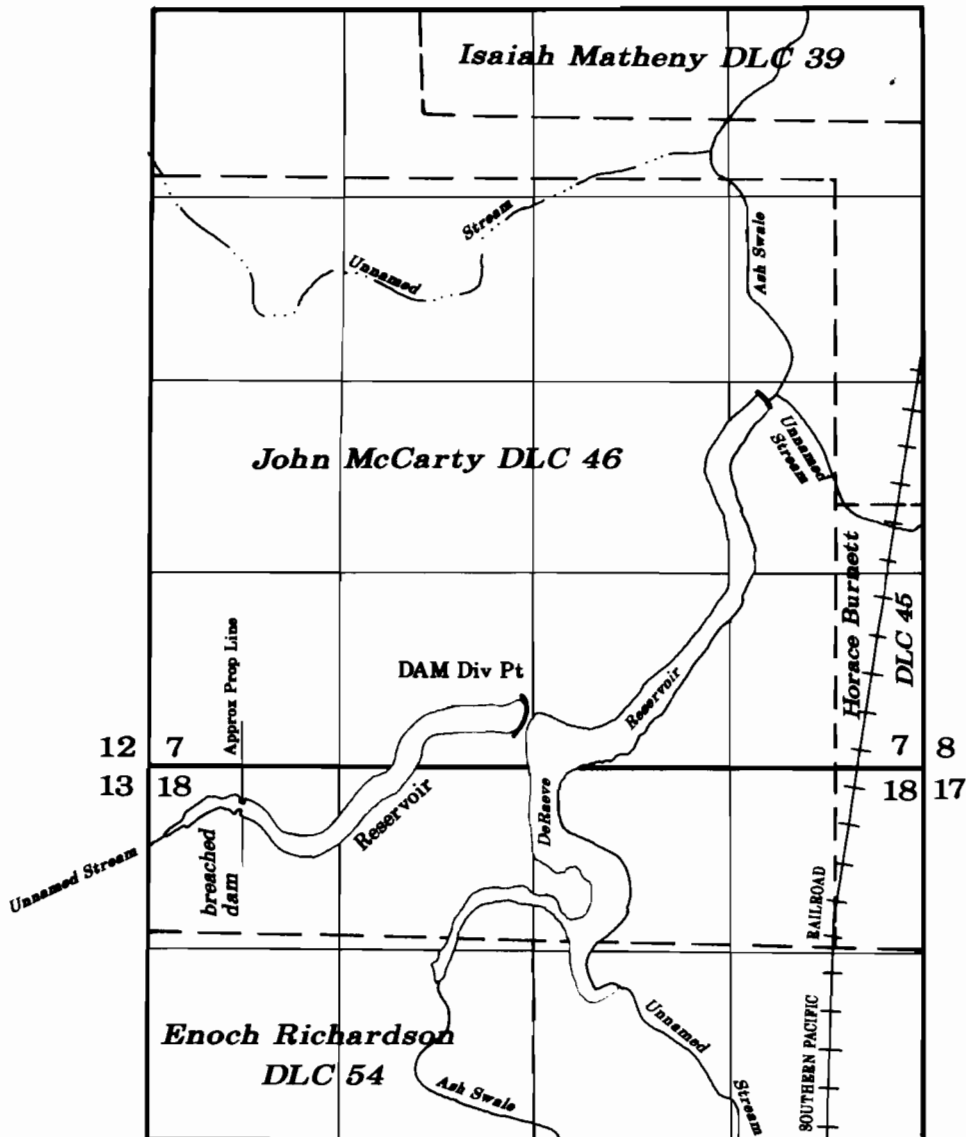

DIV PT: 3720' South and 2056' West of the NE corner of the John McCarty DLC 46.

**RECEIVED**

**FINAL PROOF SURVEY**

UNDER

OCT 21 1996

WATER RESOURCES DEPT.  
SALEM, OREGON

R-54226

R-6486

R-67984

R-10482

Application R-71578, Permit R-11459

IN NAME OF

**Marvin DeRaeve**

Surveyed: September 27, 1996

Scale: 1" = 1320'



NOTE: This map is for the purpose of identifying the location of water rights and has no intent to dimension or locate property ownership lines.