


TOWNSHIP 5 N., RANGE 29 E., W.M.  
SECTION 30

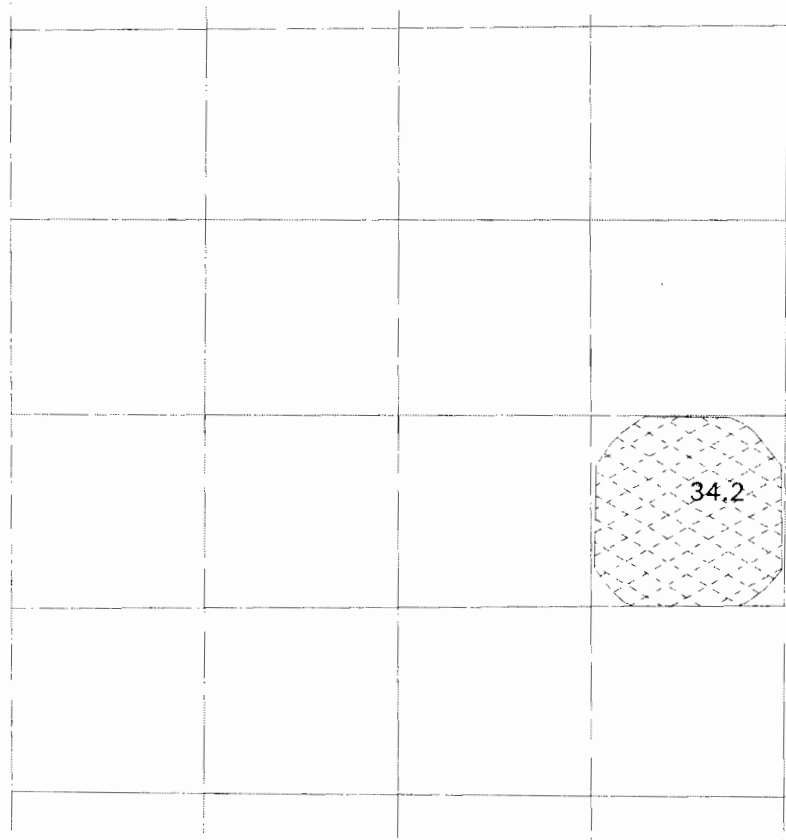

Well - 540 Feet South and 60 Feet West from the E 1/4 Corner  
Section 30.

FINAL PROOF SURVEY

BY WATER RESOURCES DEPARTMENT

Application G-11223 Permit G-10324

SCALE 1 inch = 1320 feet

