


# T.5S.R.2W.W.M.

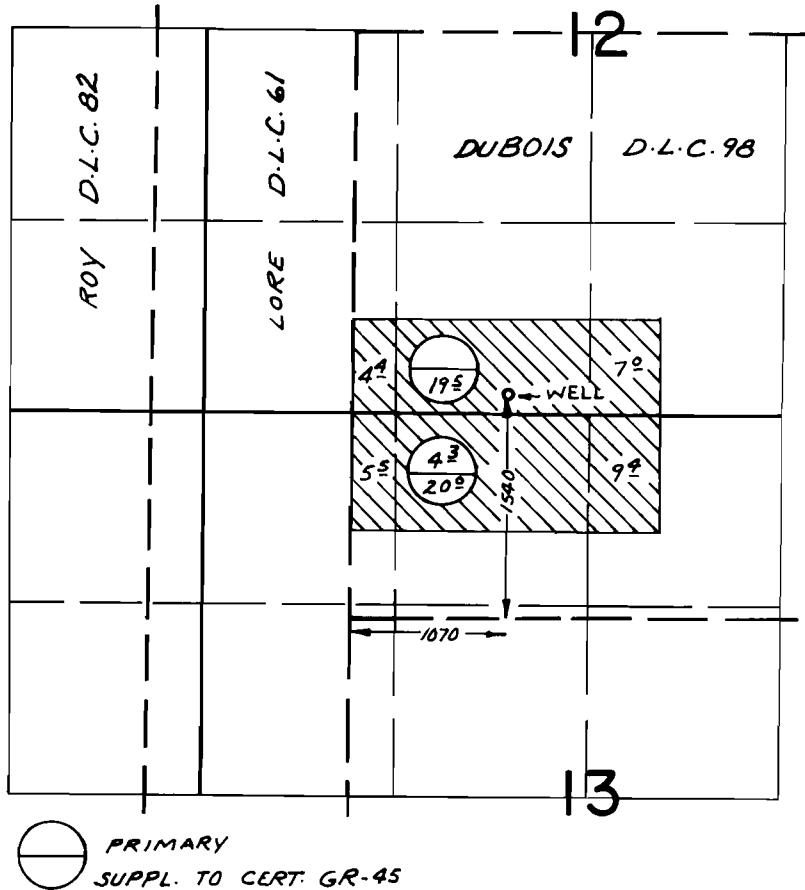

## FINAL PROOF SURVEY UNDER

Application No. G-5331 Permit No. G-5281  
IN NAME OF

PIONEER TRUST CO.

Surveyed AUG. 3, 1976. by R. MUCKEN