

CLAIM OF BENEFICIAL USE MAP
Application Number S-80862 - Permit Number 52727

Section 22, T. 38 S., R. 8 W.,
Willamette Meridian,
Josephine County, Oregon

Date: March 21, 1998

FOUND 1/2" I. PIPE

Found 1/2" Iron Pipe
P.O.B. of Survey

1438 gallon water tank
North 932 feet East 386
feet from W. 1/4 Cor. of
said Section 22

POINT OF DOMESTIC USE
North 798.92 feet
East 586.28 feet
From the N. 1/4 Corner
of said Section 22.

Un-named Creek

POINT OF DIVERSION

Native Rock Dam & Catch Basin
North 810 feet, East 167 feet
from West 1/4 Corner of said Section 22


POINT OF USE

Domestic use including 1/2 acre for lawn
and garden areas. (Limited Season)

SW 1/4 OF THE NW 1/4

W. 1/4 Corner
Section 22, T. 38 S.,
R. 8 W., W.M.

THE PURPOSE OF THIS MAP IS TO IDENTIFY
THE LOCATION OF THE WATER RIGHT AND IS
NOT INTENDED TO PROVIDE DIMENSIONS OR
LOCATION OF PROPERTY OWNERSHIP LINES.

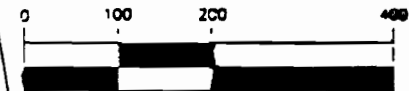

(IN FEET)
1 inch = 200 ft


Street Address
540 North Gold Canyon Drive

SURVEYED FOR:

Linda Hagganjes
1130 Woodside Road
Berkeley, CA. 94708

SURVEYED BY:

P.B. Wickham
P.O. Box 564
Grants Pass, OR. 97526
Survey performed 2-26-98

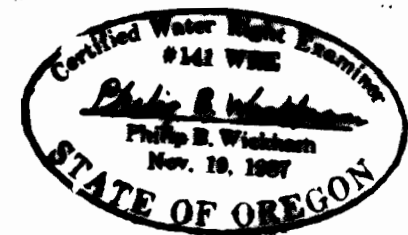

Expires
06-28-98

RECEIVED

MAY 26 1998

WATER RESOURCES DEPT
SALEM, OREGON

TO HWY. 99 →