


T. 7 S., R. 15 E., WM

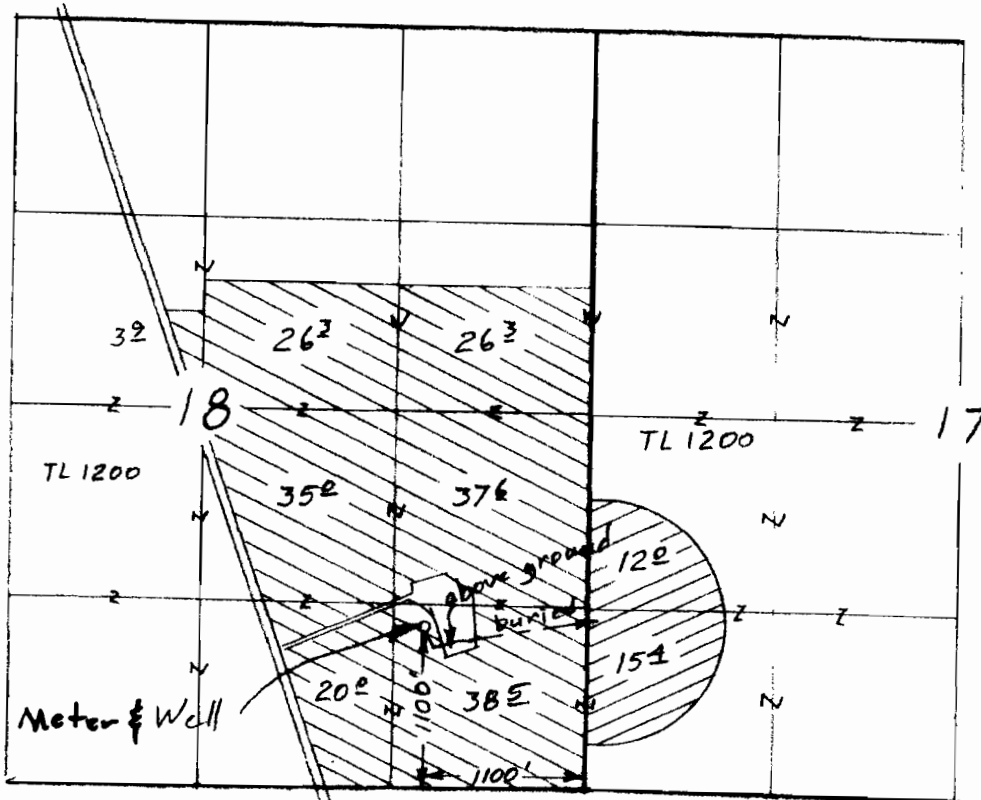

Scale
1" = 1320'
(4" = 1 mile)

Surveyed July 26, 2007

- ⊗ Certificate 80485 (Remaining Right) 187½ acres
- ⊗ T-8885 TO: 27½ acres

RECEIVED

NOV 21 2008

WATER RESOURCES DEPT
SALEM, OREGON

Claim of Beneficial Use Map
for
Columbia Empire Farms, Inc.
(R-2 Ranch)



Renewal Dec 31, 2009

Transfer T-8885

This map is for the purpose of locating a water right only and has no intent to provide legal dimensions or the location of property lines.

ESTES SURVEYS, LLC

PO Box 17619
Salem, OR 97306-7619
(503) 586-7800

80362 Arnold Rd
Bend, OR 97702
(541) 382-7391