



THIS MAP WAS PREPARED FOR THE PURPOSE OF IDENTIFYING THE LOCATION OF THE WATER RIGHT AND IS NOT INTENDED TO PROVIDE LEGAL DIMENSIONS OR LOCATIONS OF PROPERTY OWNERSHIP LINES.

T11S; R5W; W. M.

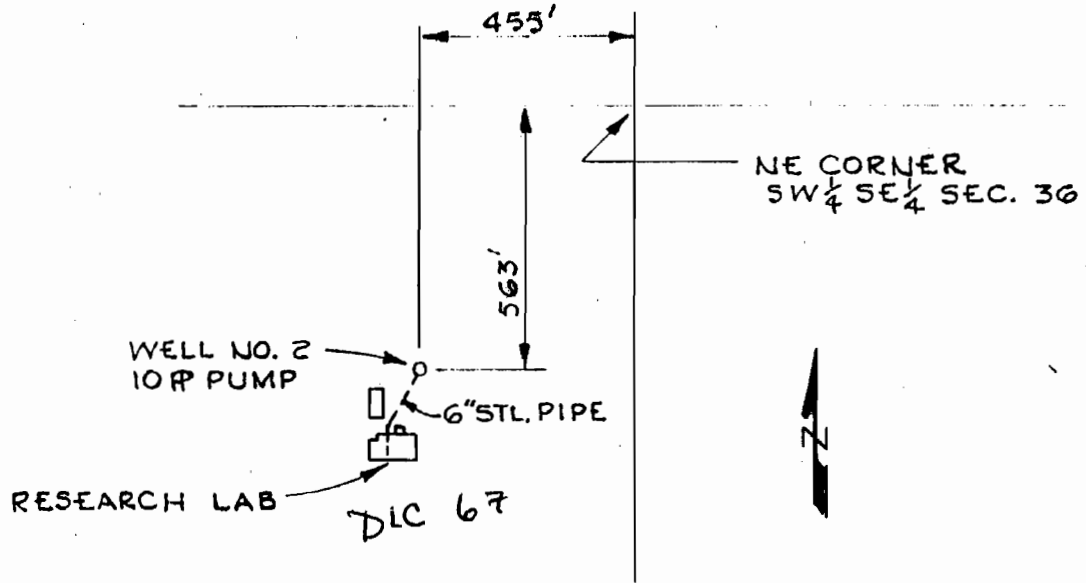

SCALE 1" = 400'

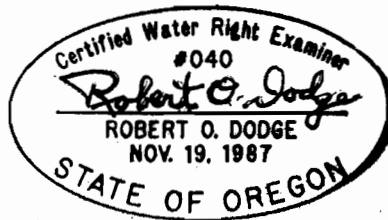

Map amended by WRD Staff 12-1-2008 rwl

**FINAL PROOF SURVEY  
UNDER**

APPLICATION NO. G-12389 PERMIT NO. 12131  
IN NAME OF

**OREGON DEPARTMENT OF FISH AND WILDLIFE**  
SURVEYED: 2/11/97 BY: DODGE

RECEIVED

FEB 16 1997

SALES