


CLAIM OF BENEFICIAL USE AND SITE REPORT
IN THE NAME OF

WAYNE H. BREEZE
7159 Pine Ridge Drive
Medford, Or. 97504



Application No. R72096 and 72097

Permit No. R11474 and 51503

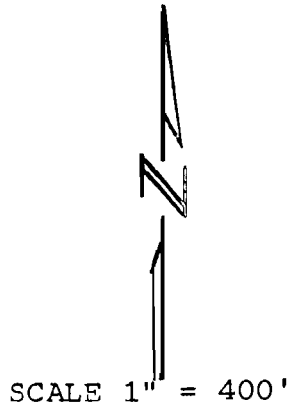

POND SITUATED 1106 ft.
NORTH AND 189.9 ft WEST
OF 1/4 COR TO SEC. 19
AND 20, T37S, R1E, WM.

CISTERN SITUATED 849.9
ft. NORTH AND 88.2 ft.
WEST OF 1/4 COR TO SEC.
19 AND 20, T37S, R1E, WM.

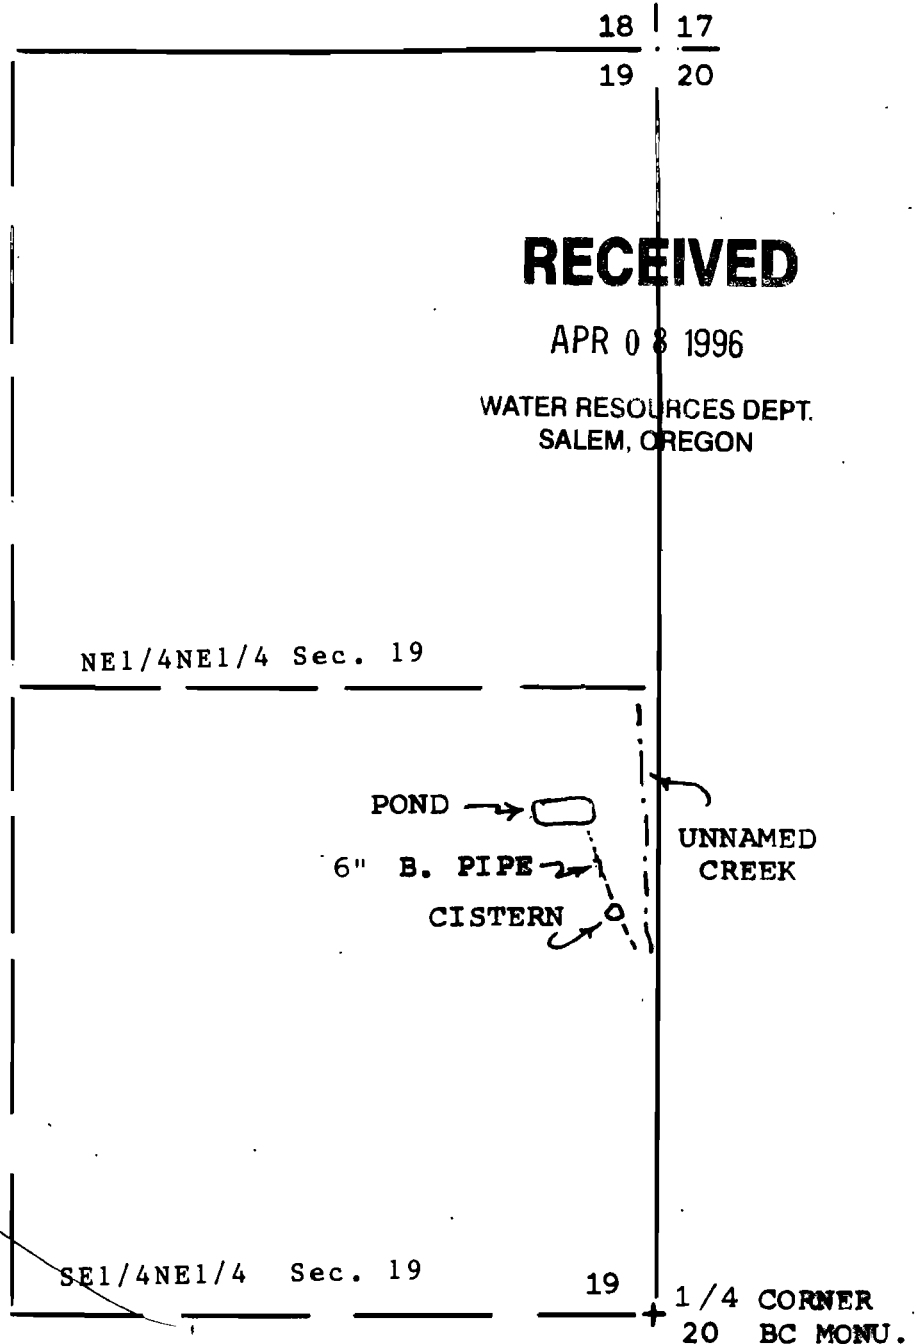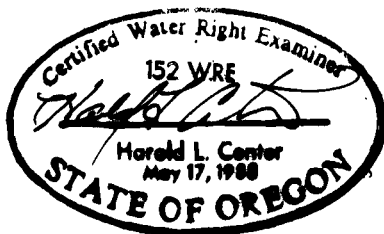

This map was prepared for the purpose of identifying the location of a water right only and is not intended to provide legal demensions or location of property ownership lines.

CLAIM OF BENEFICIAL USE AND SITE REPORT
IN THE NAME OF


WAYNE H. BREEZE
7159 Pine Ridge Drive
Medford, Or. 97504

Application No. R72096 and 72097

Permit No. R11474 and 51503

ATTACHMENT No. 2

Pond is situated 1106.0 ft. north and
189.9 ft. west of the 1/4 corner to
sections 19 and 20, T. 37 S., R. 1 E., W.M.

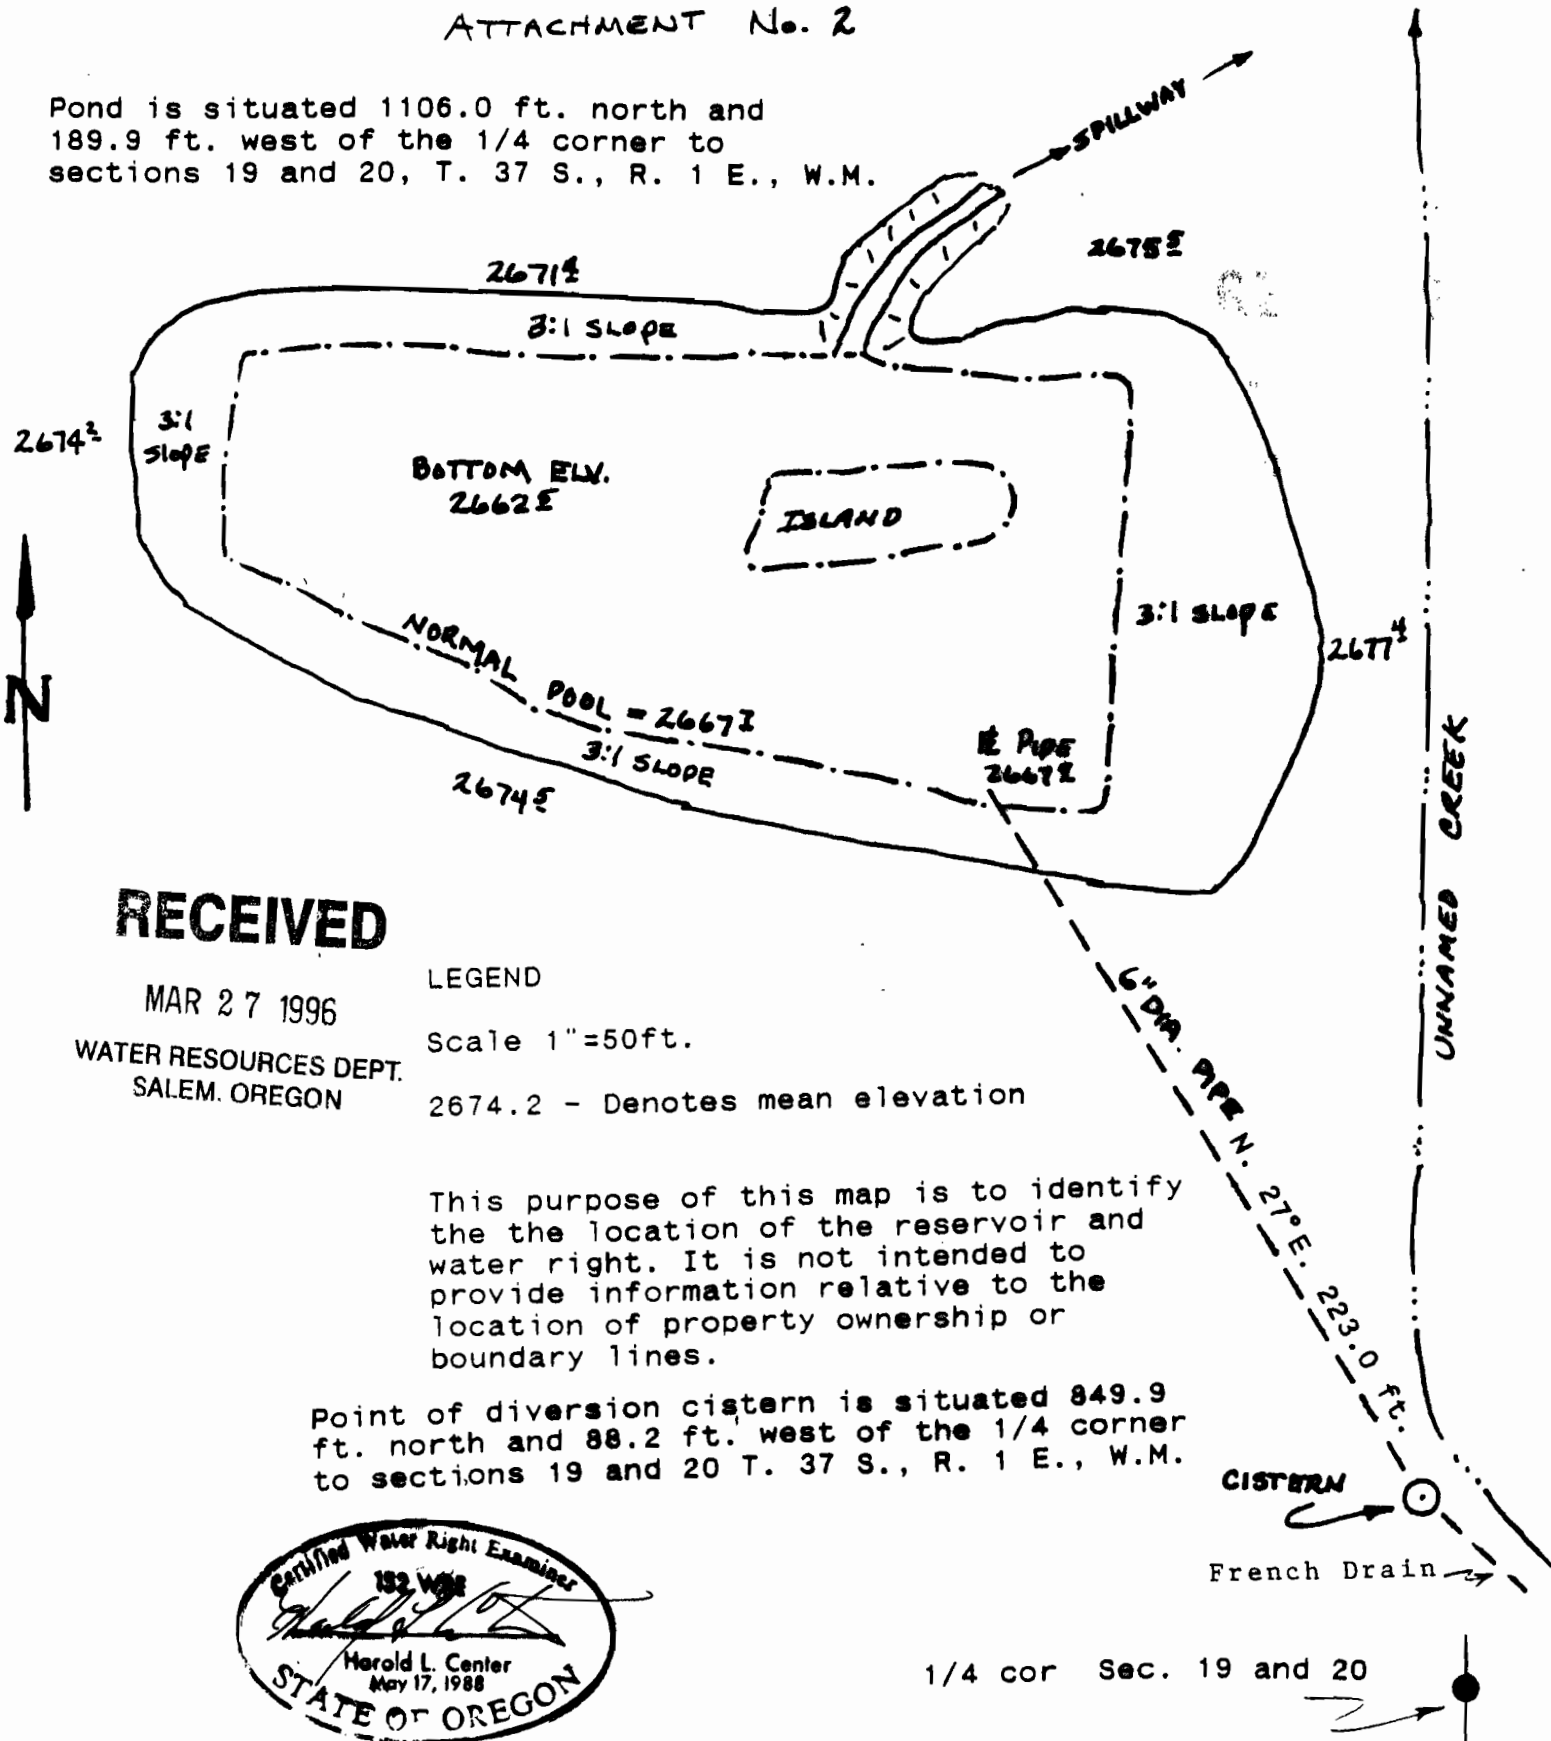

RECEIVED

MAR 27 1996

WATER RESOURCES DEPT.
SALEM, OREGON


LEGEND

Scale 1"=50ft.

2674.2 - Denotes mean elevation

This purpose of this map is to identify
the the location of the reservoir and
water right. It is not intended to
provide information relative to the
location of property ownership or
boundary lines.

Point of diversion cistern is situated 849.9
ft. north and 88.2 ft. west of the 1/4 corner
to sections 19 and 20 T. 37 S., R. 1 E., W.M.

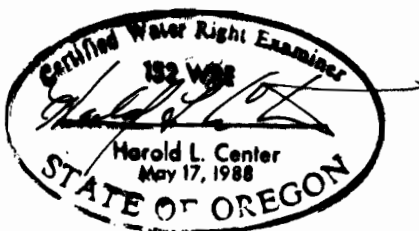

1/4 cor Sec. 19 and 20

RECEIVED

MAR 27 1996
WATER RESOURCES DEPT.
SALEM, OREGON


**CLAIM OF BENEFICIAL USE AND SITE REPORT
IN THE NAME OF**

**WAYNE H. BREEZE
7159 Pine Ridge Drive
Medford, Or. 97504**

Application No. R72096 and 72097

Permit No. R11474 and 51503

ATTACHMENT No. 1.

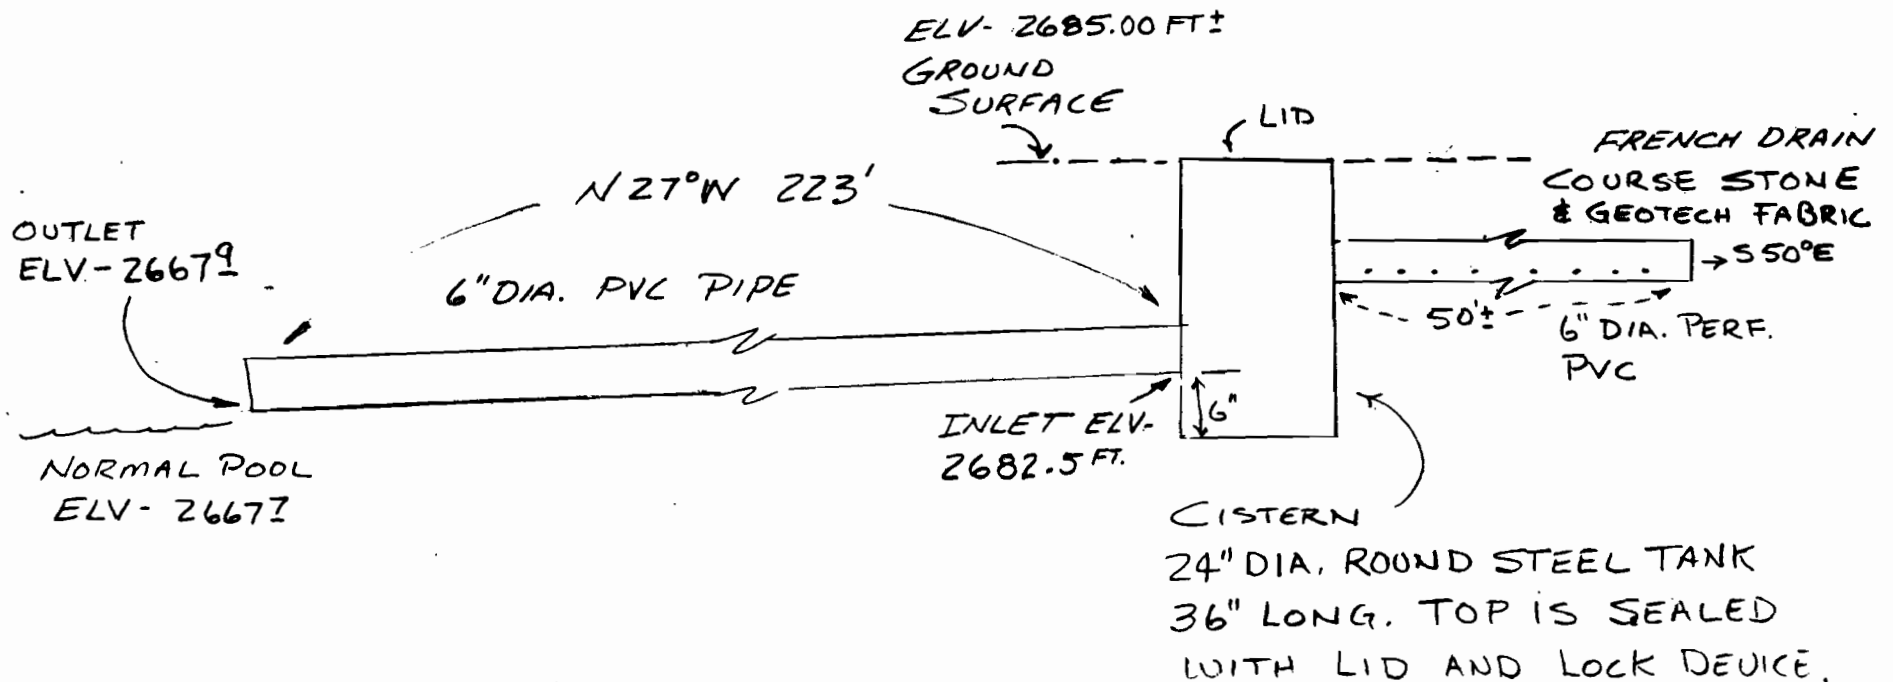

NOT TO SCALE

