


FINAL PROOF SURVEY

UNDER PERMITS; S-52856, G-12880, R-11982

LOCATED IN
SECTION 16
T.16 S., R.5 E., W.M.
LANE COUNTY, OREGON

SCALE: 1"=1320'-0"

RECEIVED
SEP 25 2000
WATER RESOURCES DEPT.
SALEM, OREGON

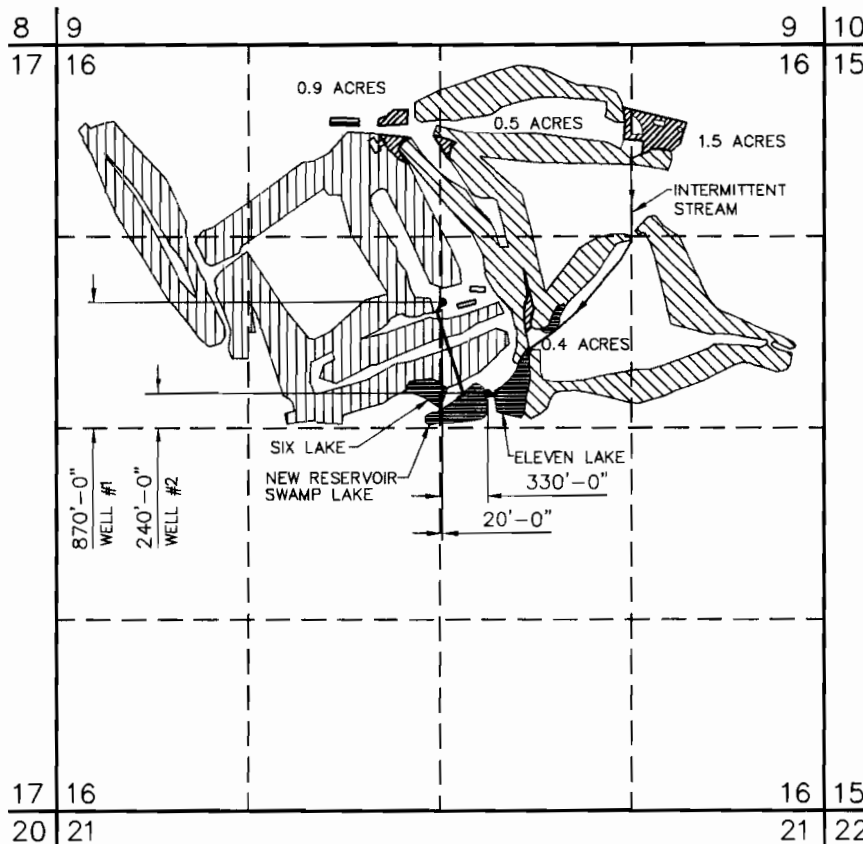

LEGEND:

- = SECTION LINES
- - - = FORTY LINES
- ▨ = NEW AREAS BEING APPLIED FOR.
- = EXISTING GROUND WATER WELLS
- ▨ = AREA UNDER PERMIT NO. R-4637, 30744, G-3001, & 40759.
- ▨ = AREA UNDER PERMIT NO. R-5521, 34643, & G-4699.


ACREAGE SUMMARY

SECTION 16	NE 1/4, NW 1/4	0.9 ACRES
	NW 1/4, NE 1/4	0.5 ACRES
	NE 1/4, NE 1/4	1.5 ACRES
	SW 1/4, NE 1/4	0.4 ACRES

NOTE: 1- PRESENT IRRIGATION SYSTEM IS CONNECTED TOGETHER WITH THE TWO WELLS THAT ARE SHOWN.
3- AREAS SHOWN ARE IN ACRES.
4- DISTANCES SHOWN ARE IN FEET.

I J. EDWARD HENRICKS, BEING DULY SWORN AS A WATER RIGHT EXAMINER LICENSE NO. 170, HAVE PREPARED THIS MAP FOR TOKATEE GOLF COURSE (LARRY GIUSTINA) ON THIS 5th DAY OF SEPTEMBER 2000. THE AREAS HATCHED REPRESENT THE ACREAGES TO BE IRRIGATED OR IRRIGATED UNDER EXISTING WATER RIGHTS AS NOTED.

PREPARATION OF THIS MAP IS FOR THE PURPOSE OF IDENTIFYING THE LOCATION OF THE WATER RIGHT ONLY AND HAS NO INTENT TO PROVIDE DIMENSIONS OR LOCATION OF PROPERTY OWNERSHIP LINES.

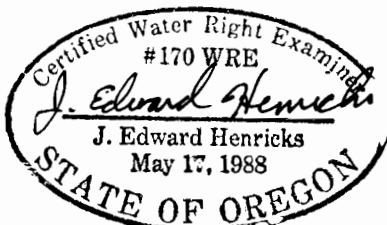

ONLY DOCUMENTS STAMPED WITH
RED INK ARE ORIGINALS.