
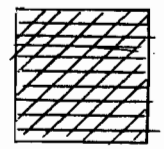
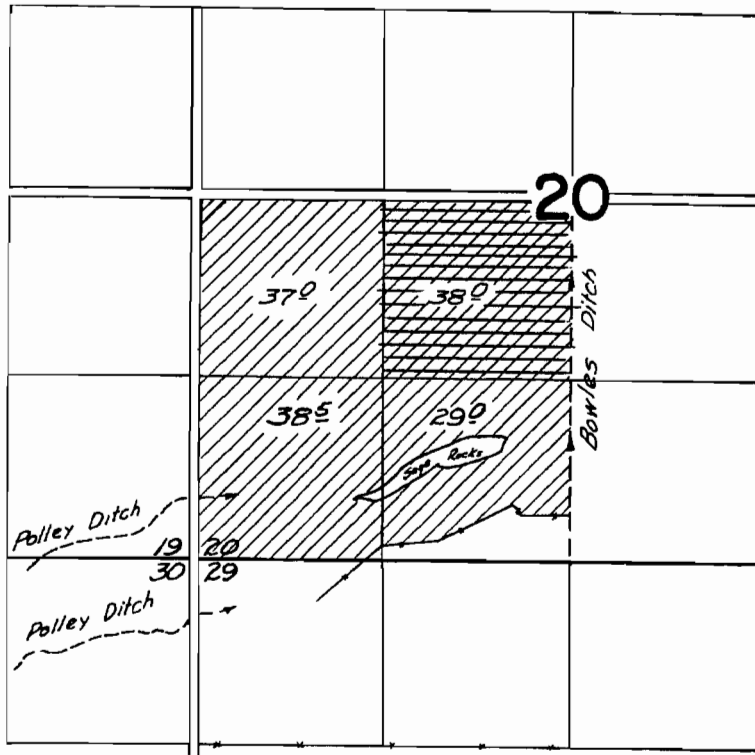


T.8S. R. 39E. W.M.

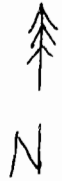

Aeres to be
Canceled under
Cert. # 34840

1" = 1320'

FINAL PROOF SURVEY UNDER

Application No. TRANSFER B-120 Permit No.
IN NAME OF

NORMAN BUTLER

Surveyed Nov. 18, 1964 by C. Gardner
Oct. 25, 26, 1967 by V. Garner

1964-9
1967-P
H.S.