
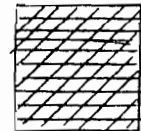


T.8S. R.39E. W.M.

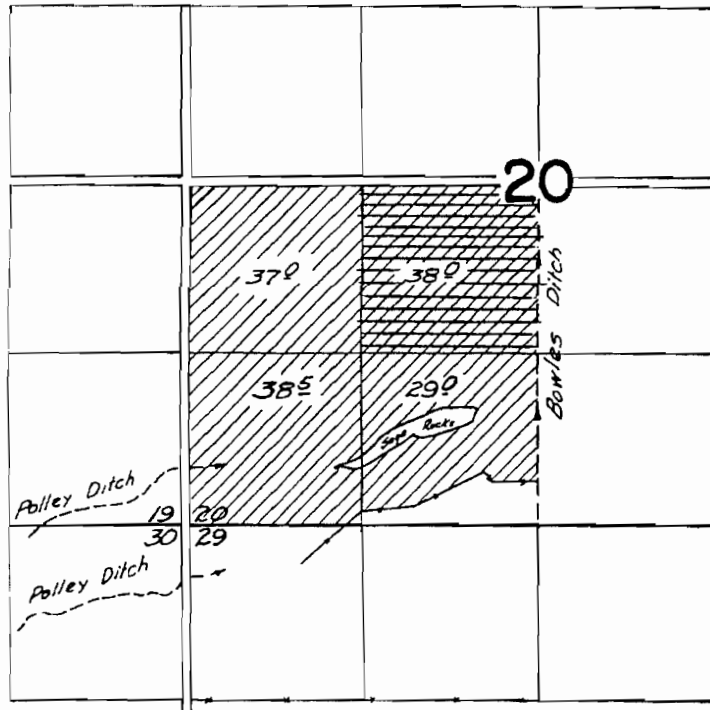

Acres to be
Canceled under
Cert. # 34840

1" = 1320'

FINAL PROOF SURVEY
UNDER

Application No. TRANSFER B-120 Permit No.
IN NAME OF

NORMAN BUTLER

Surveyed Nov. 18, 1964, by G. Gardner
Oct 25, 26, 1967 by V. Garner

1964-9
1967-F
JH