


NE1/4 NE1/4 SEC. 6 T.15S. R.16E.W.M.  
CROOK COUNTY  
1" = 100'

15 16 6 AA  
PRINEVILLE

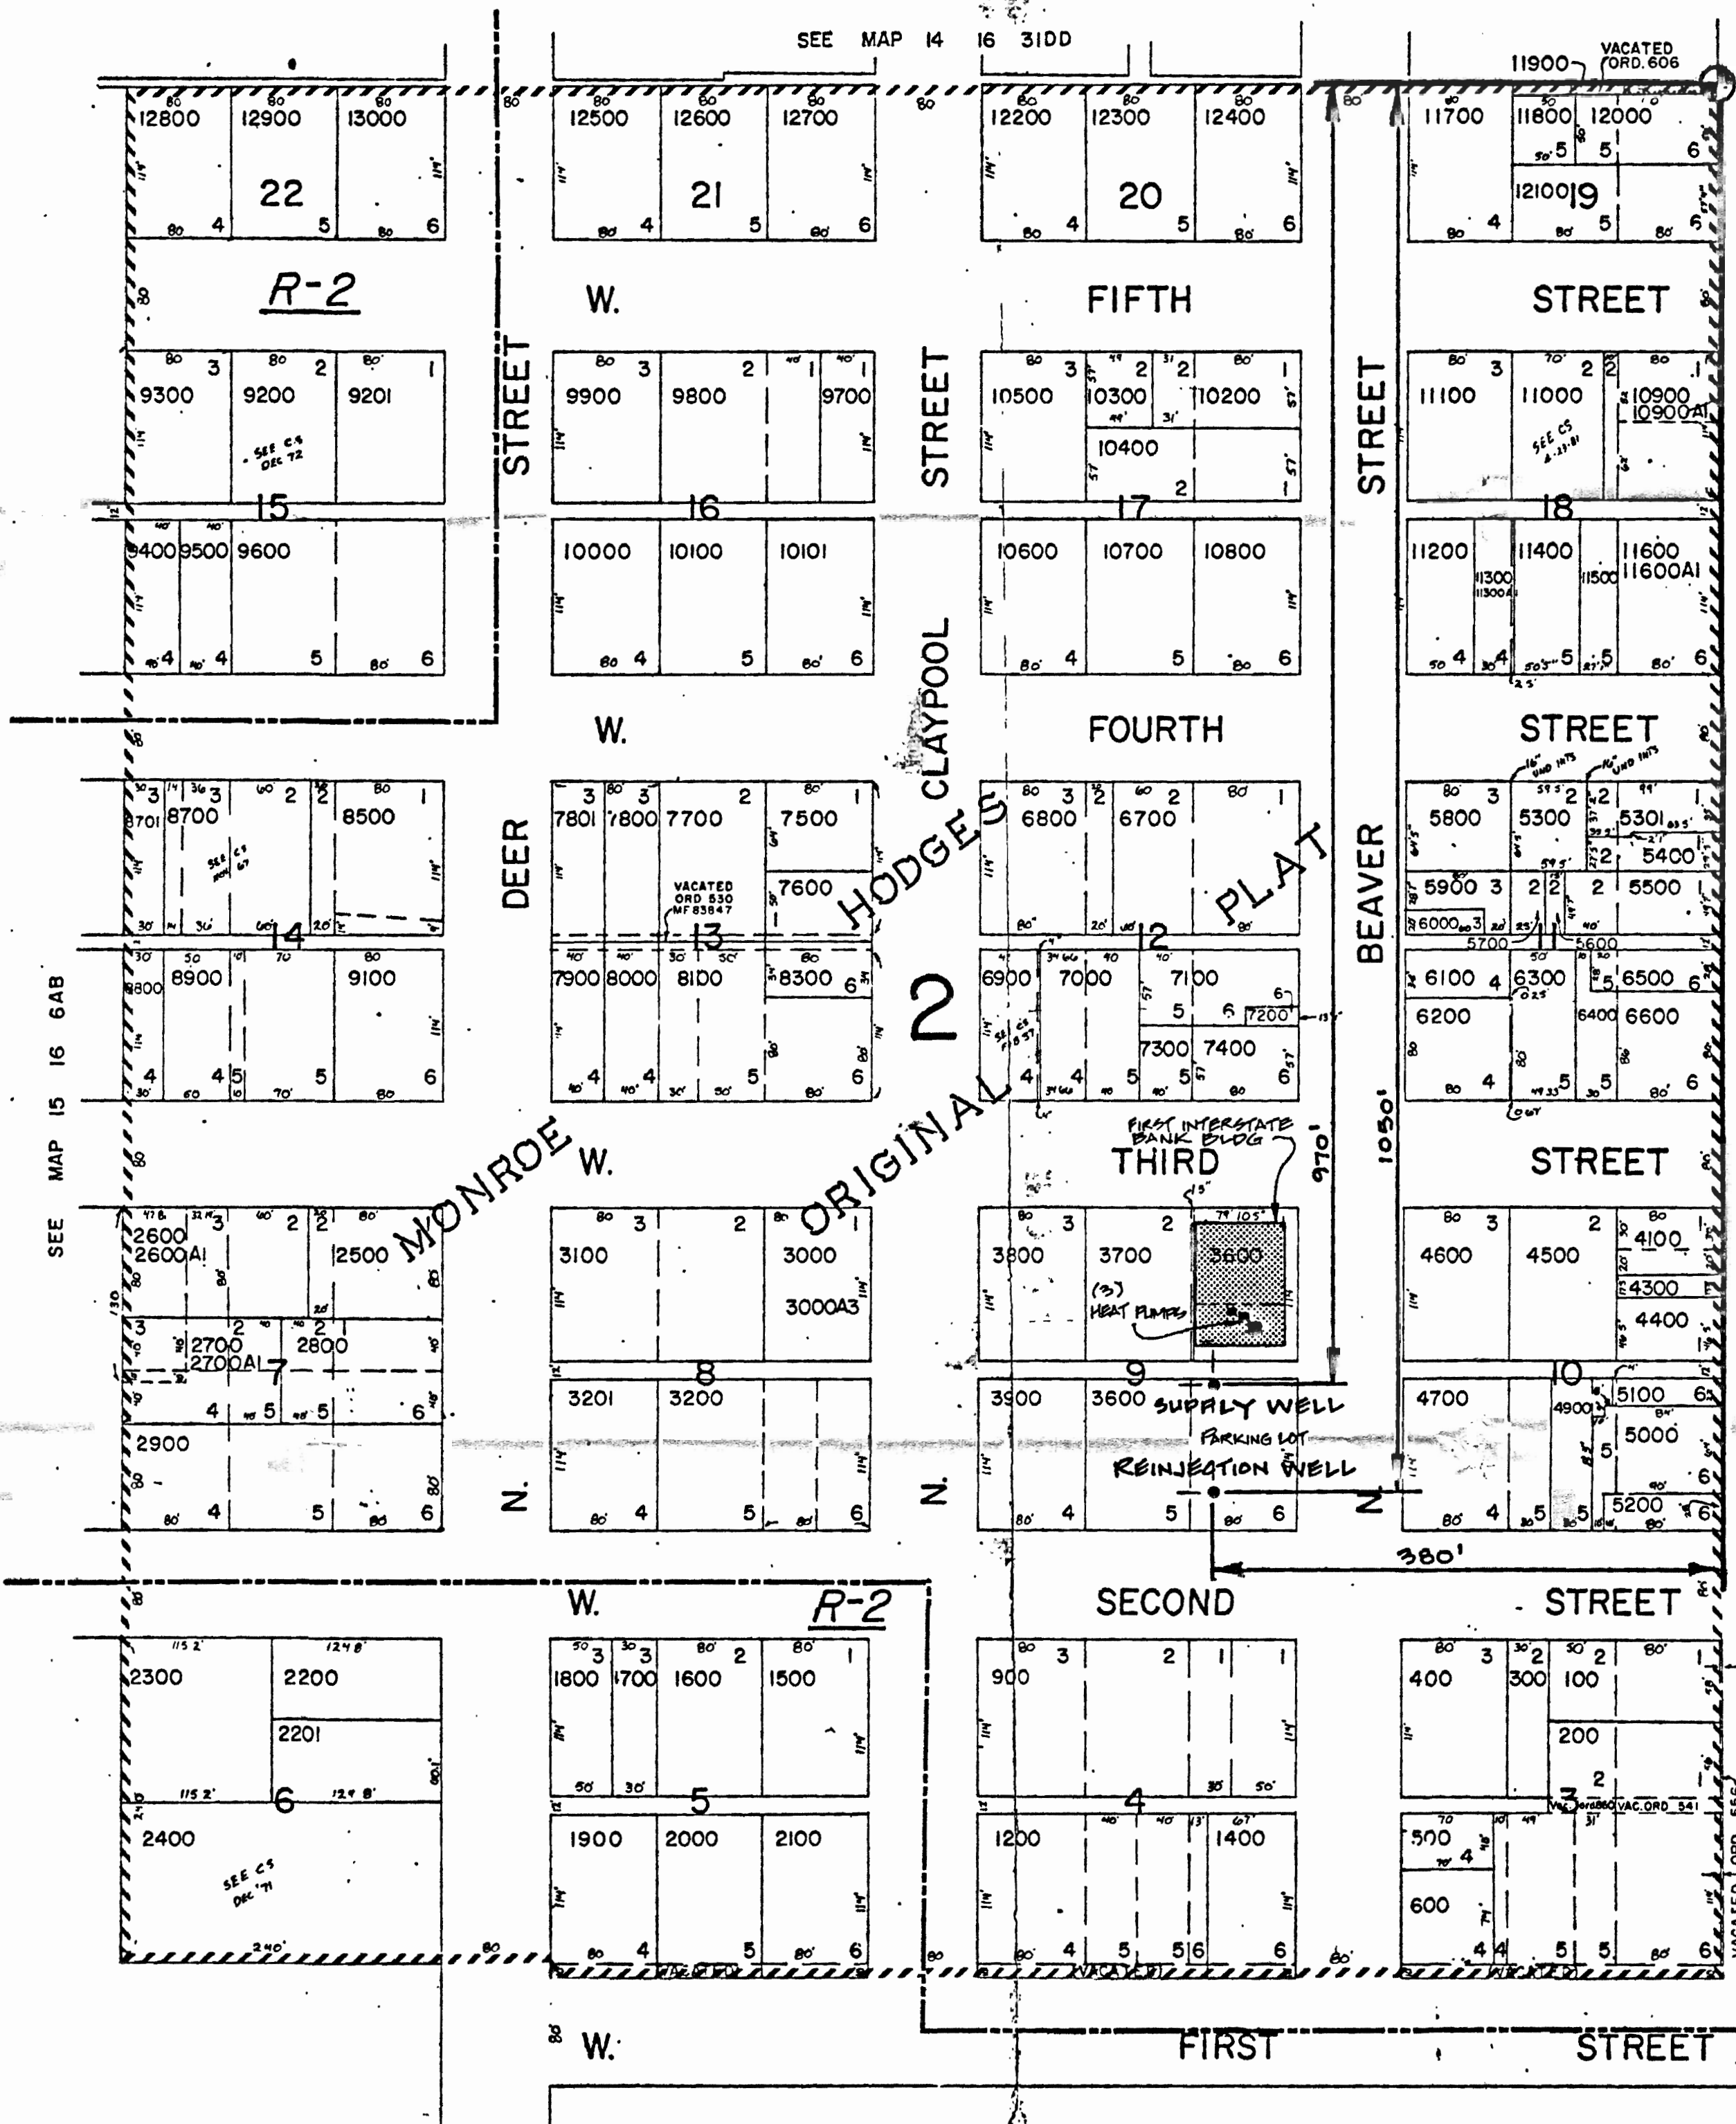

- CANCELLED NO'S
- 4001
  - 4200
  - 4800
  - 5000AI
  - 8200
  - 8400
  - 8600
  - 9000
  - 700
  - 800
  - 3300
  - 3400
  - 3500
  - 4000
  - 6301
  - 1100
  - 1000
  - 1300
  - 5001

C-1

STREET

MAIN

N

SEE MAP 15 16 58B

FINAL PROOF  
MAP



1. MAP ONLY FOR WATER RIGHTS ONLY.
2. MAP ACCURACY WITHIN 10'

Application No. 2-11689  
Permit No. G11080

15 16 6 AA  
PRINEVILLE

SEE MAP 15 16 6AD

RECEIVED  
JUL 18 1990  
WATER RESOURCES DEPT.  
SALEM, OREGON