
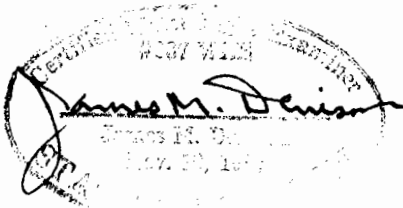


T12S, R9W., W.M.
SECTION 5 & 6
LINCOLN COUNTY, OREGON

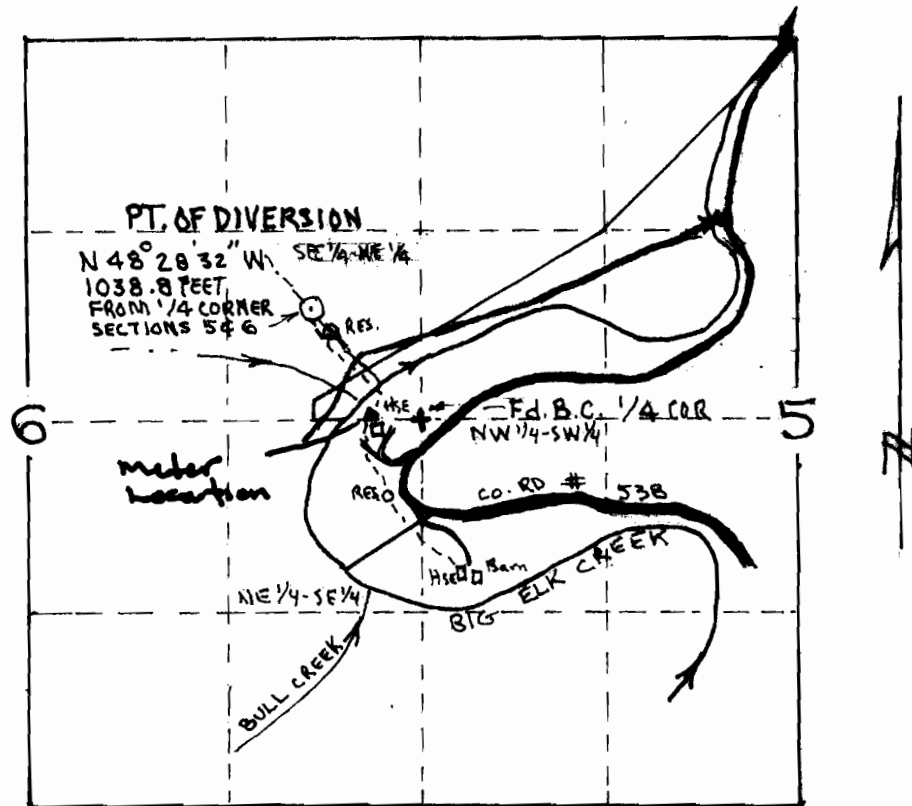

SCALE: 1" = 1320'

FINAL PROOF MAP
UNDER

APPLICATION # S - 84031

PERMIT # 53614

IN THE NAME OF

JAMES M. DENISON

SURVEYED: OCTOBER 24, 2004

BY: James M. Denison

THIS MAP PREPARED SOLEY FOR THE PURPOSE OF SHOWING LOCATION OF A WATER RIGHT, AND IS NOT INTENDED FOR USE TO PROVIDE DIMENSIONS OR LOCATION OF PROPERTY OWNERSHIP LINES.

Final Proof Map