


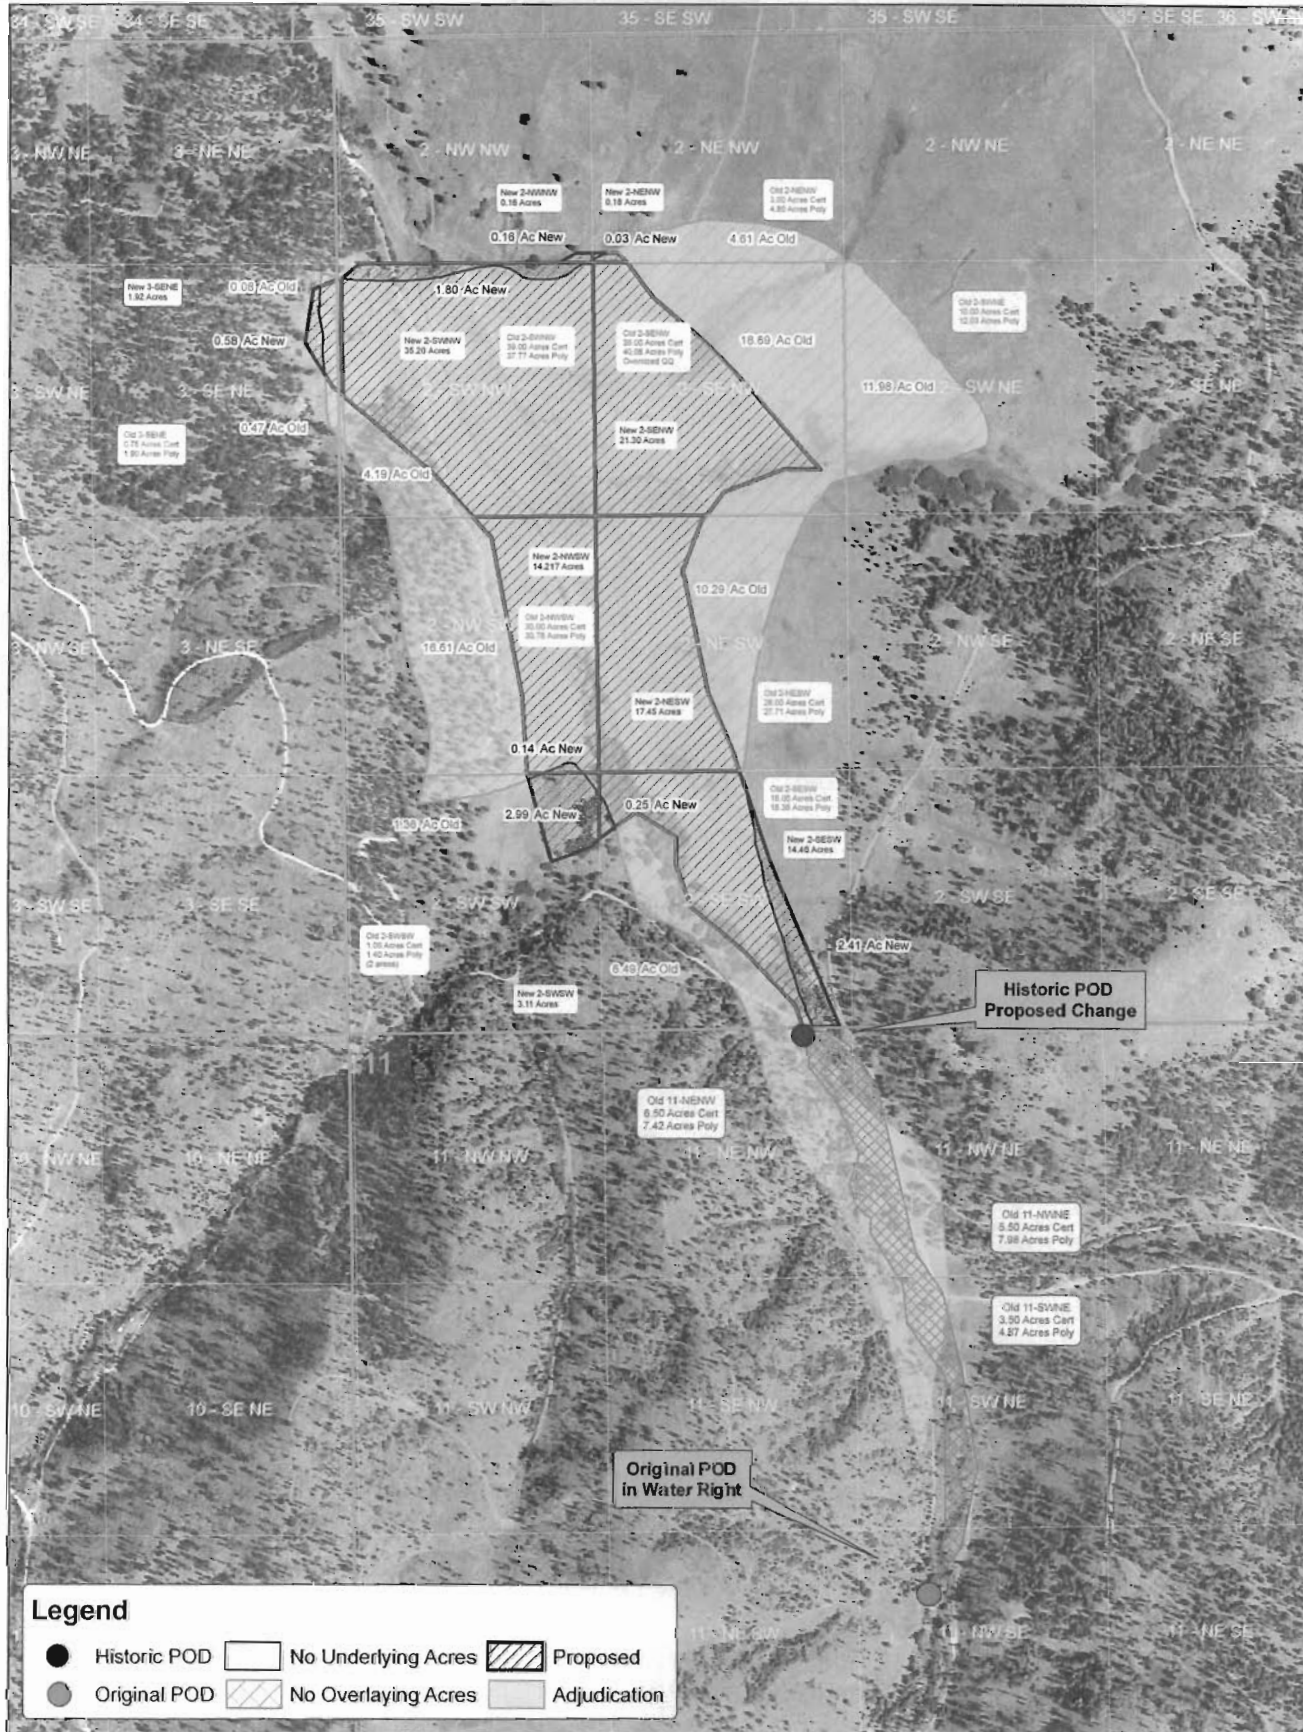

* Historic P.O.D. located: 60 ft. South and 2385 ft. East from NW Corner, Section 11

Umatilla Basin
Willow Creek Sub-Basin
Morrow County, Oregon
T5S, R27E
Certificate # 220

5S27e2_T10260_2.mxd



Disclaimer
The water rights shown on this map and the accompanying report have been interpreted by the Department's staff from information in the Department's files and are intended to represent that information graphically. Locations shown are only approximate and should not be used in legal, financial, or other critical decisions. For more accurate legal location information, please consult the Department.

T-10260

ph Pendleton 05/28/2008

* Amended 12/17/2008