


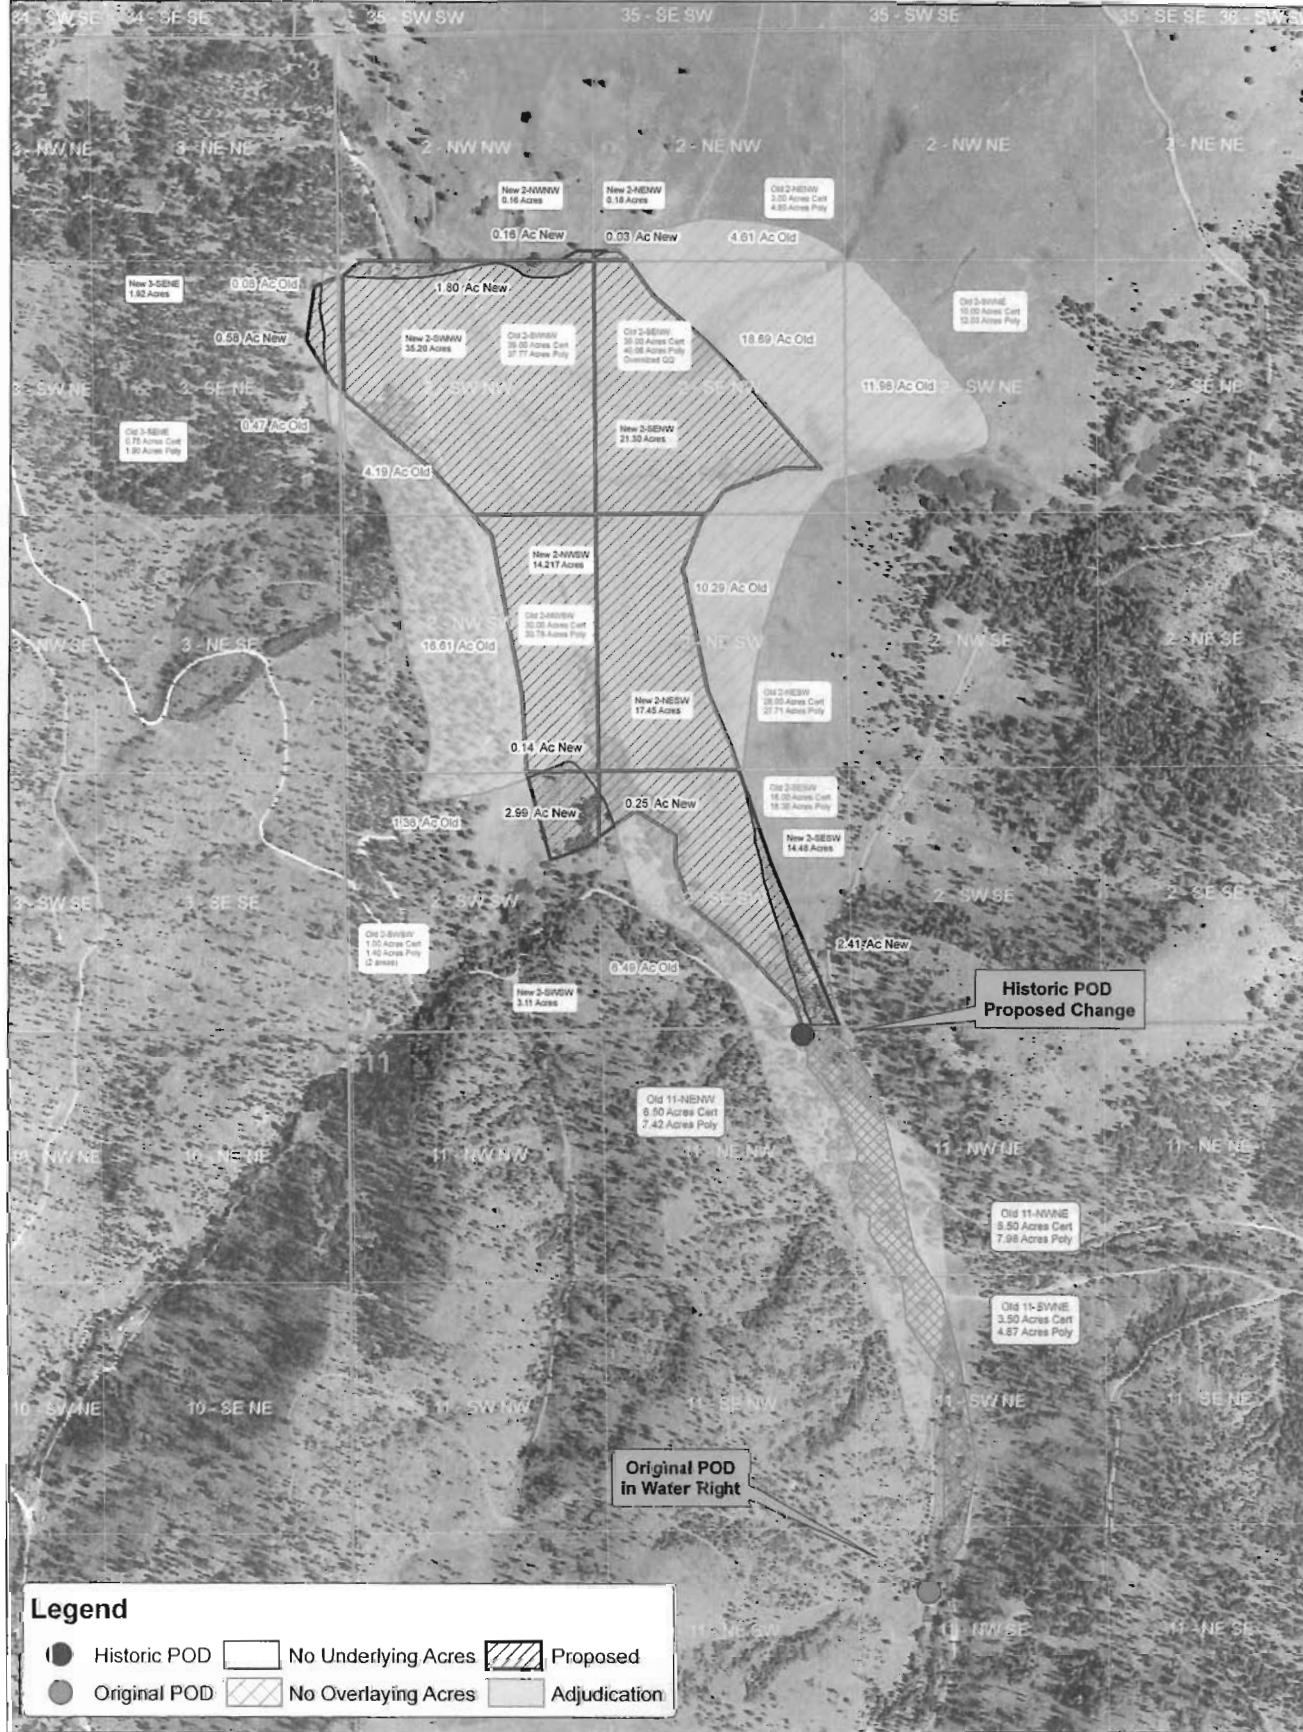

Umatilla Basin
Willow Creek Sub-Basin
Morrow County, Oregon
T5S, R27E
Certificate # 220

5S27e2_T10260_2.mxd



T-10260

ph Pendleton 05/28/2008

Amended 12/17/2008