

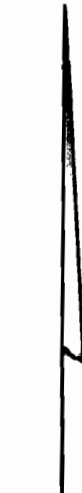


T.4S. R.1E., W.M

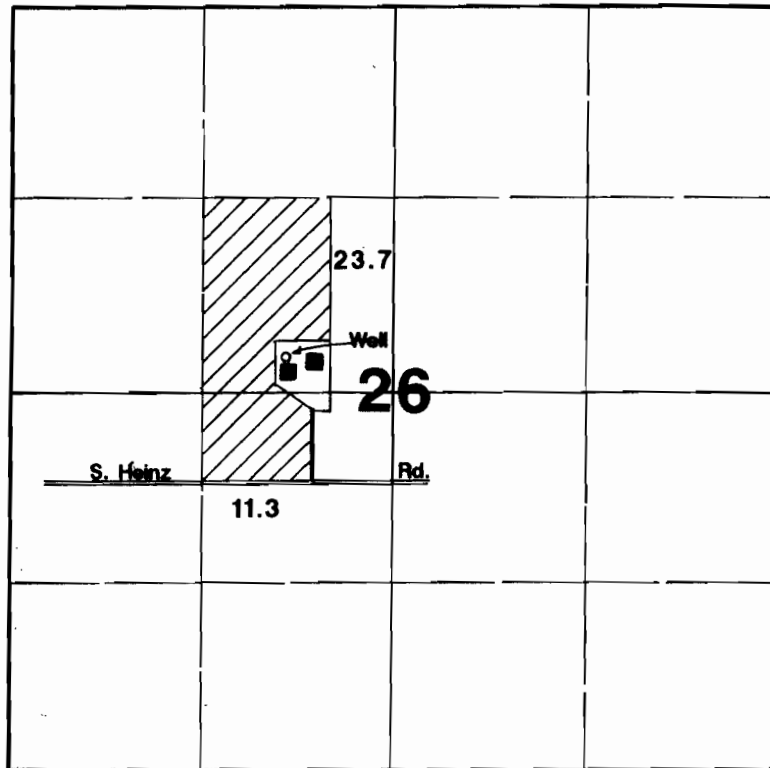

1" = 1320'

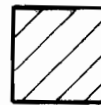

Area Irrigated

Well located 210'N & 720'W from center of Section 26.

RECEIVED

JUN 18 1998

WATER RESOURCES DEPT.
SALEM, OREGON

Final Proof Survey

Application #: G-12822 Permit #: G-11729

In Name Of

Ron Nofziger

Surveyed on April 25, 1998 by JM Schuette

This Map Was Prepared For The Purpose Of Identifying The Location Of A Water Right Only And Is Not Intended To Provide Legal Dimensions Or Location Of Property Ownership Lines.

