


RECEIVED

SEP 30 1999

WATER RESOURCES DEPT.
SALEM, OREGON


FINAL PROOF SURVEY

This drawing has been prepared for Greg Albrich to demonstrate that he has completed all required improvements required under File No. 72410 which was assigned Permit No. 52201 for the appropriation of water from a spring source of Scarlet Creek in the Southwest Quarter of the Southwest Quarter of Section 1, Township 5 South, Range 10 West of the Willamette Meridian, Tillamook County, Oregon.

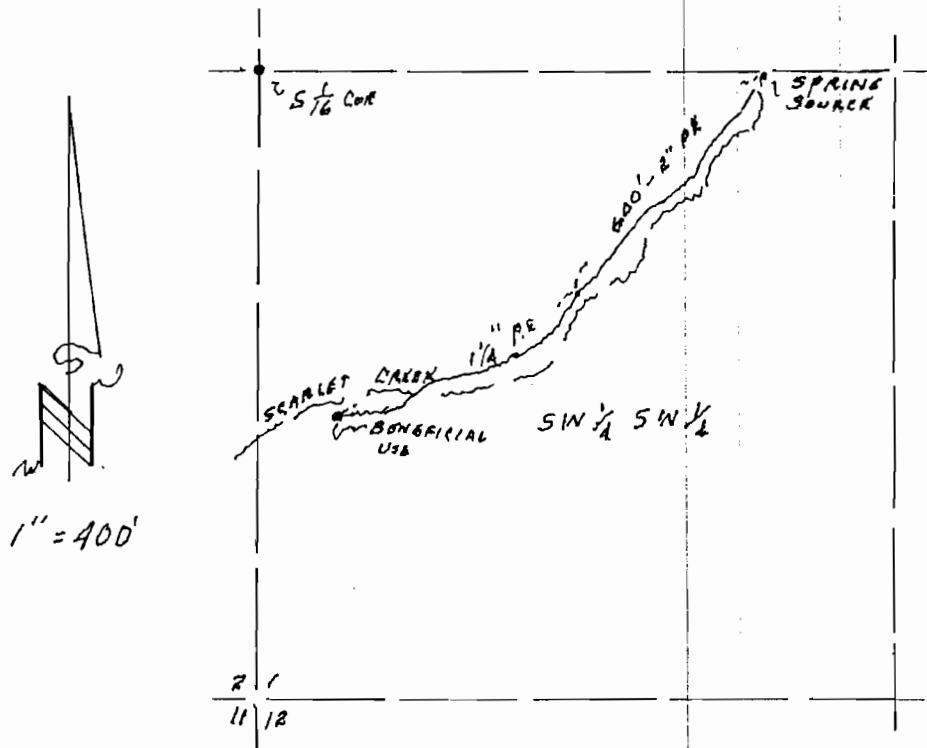

Note:

The spring source has been improved by the placement of a short piece of perforated 4-inch PVC pipe in a rock bed. The improved spring was covered with selected native soil.

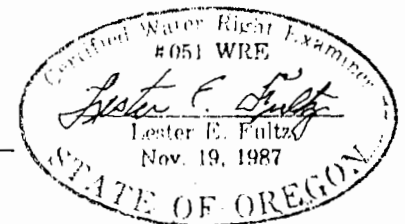

Notes:

1. Refer to the notes on the Water Application Map filed with the Application. Field survey date on that map is 19th day of September, 1992.
2. The Point of Diversion was located further upstream because Elk contaminated the water in Scarlet Creek. The present improvements are superior to the original design.
3. The Point of Diversion is South $89^{\circ}50'$ East, 1050 feet from the S $1/16$ Corner of said SW $1/4$ SW $1/4$ of said Section 1.
4. The Point of Beneficial Use is South $50^{\circ}30'$ West, 1150 feet from the Point of Diversion.
5. The first 600-feet of pipe is 2-inch PE, the remainder is $1\frac{1}{4}$ P.E. The pipe is buried for its entire length.
6. The change in location of the Point of Diversion improved the water pressure at the Point of Beneficial Use.