


T.15S., R.10E., W.M.

RECEIVED

MAR 23 2007

WATER RESOURCES DEPT
SALEM, OREGON

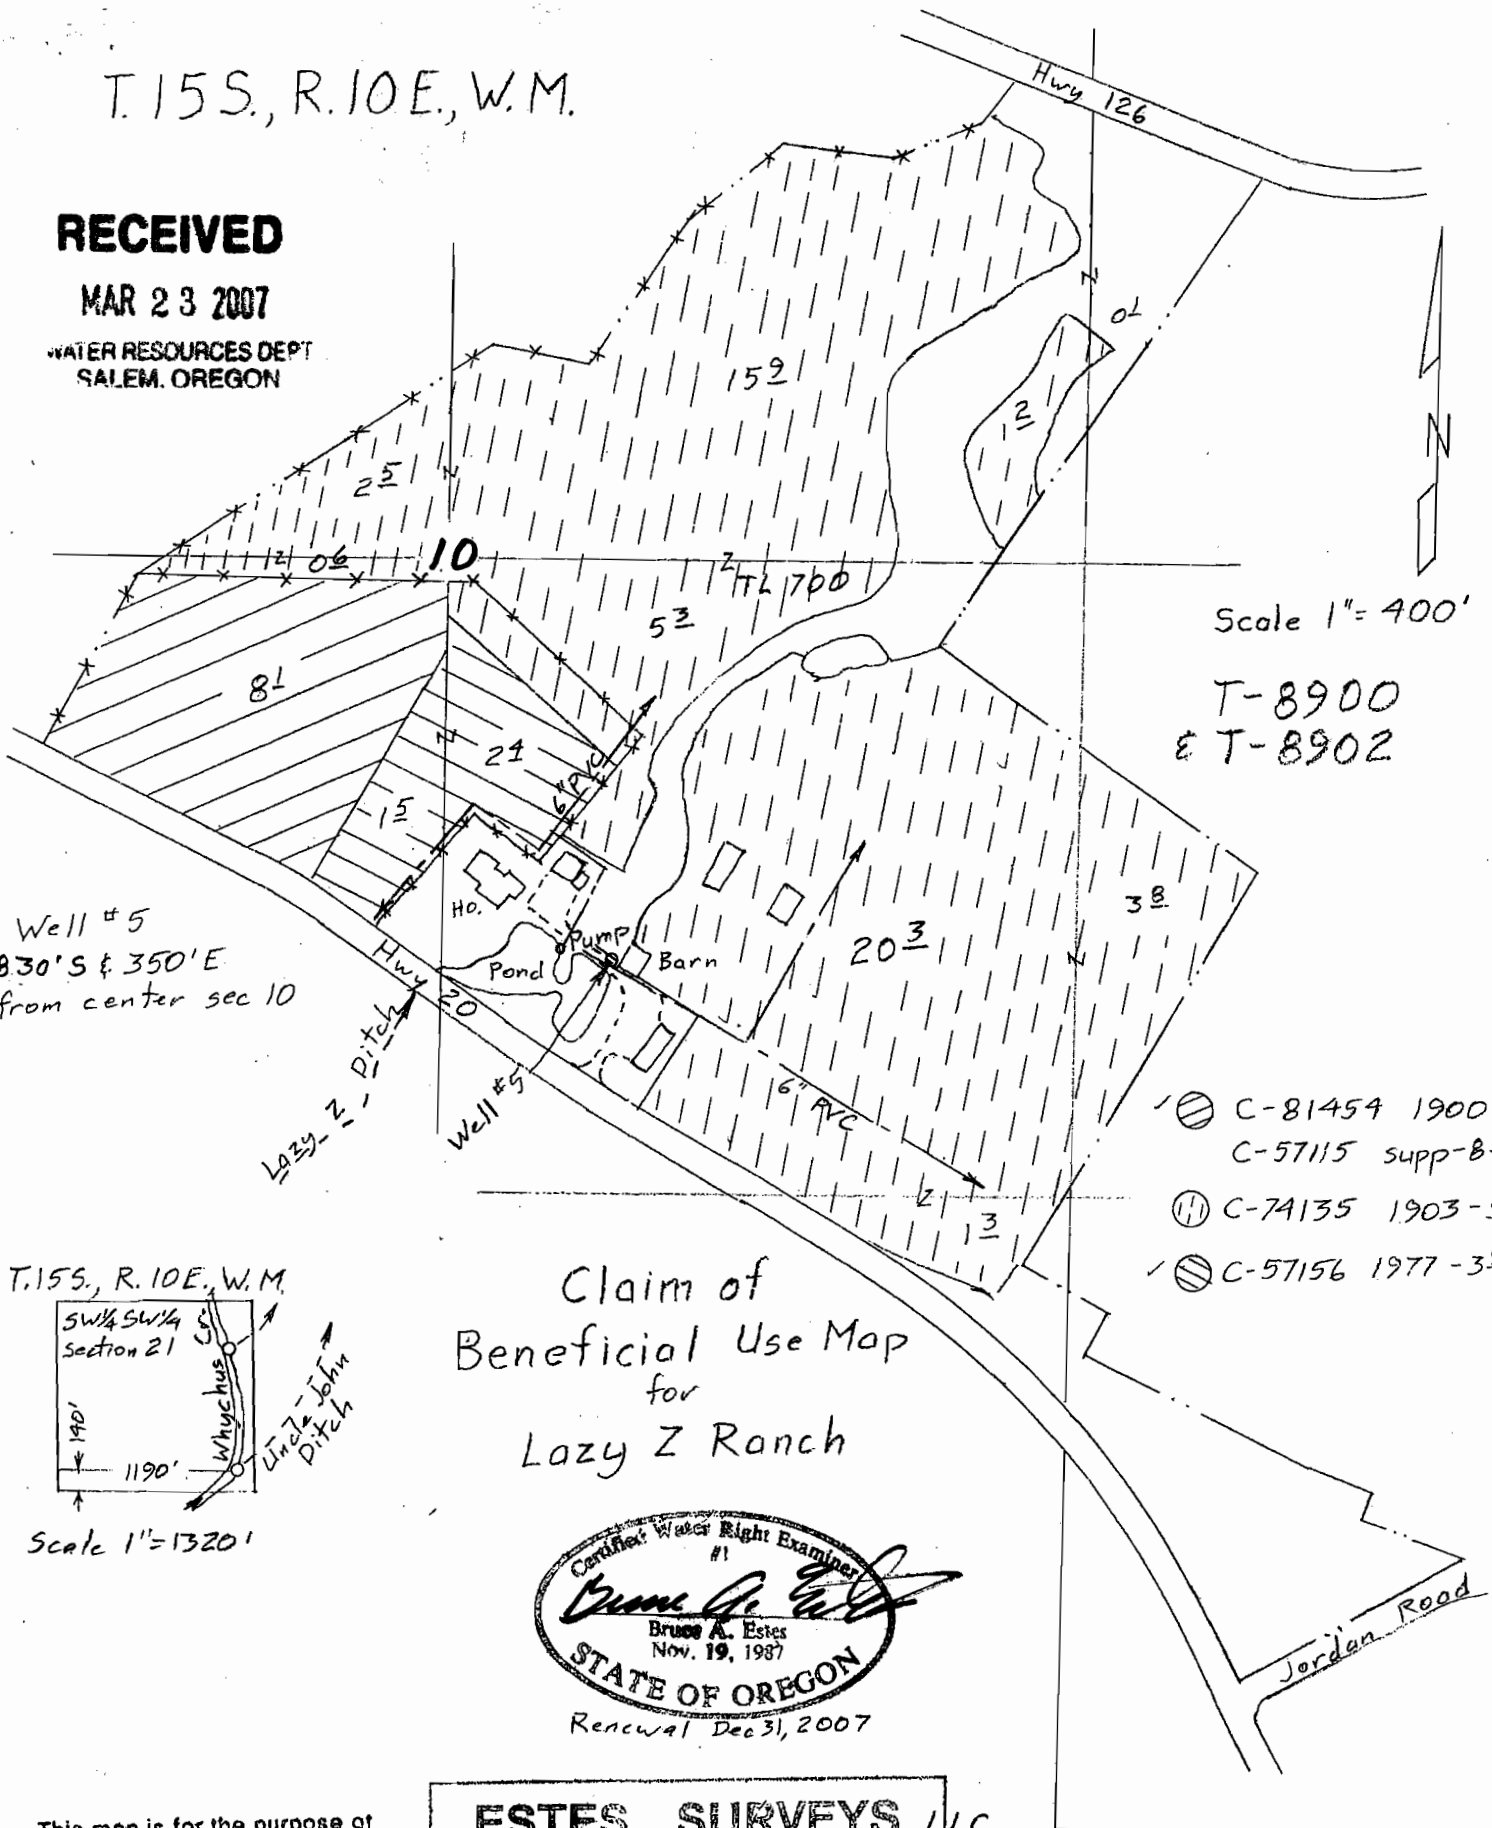


Scale 1" = 400'

T-8900
E T-8902

Well #5
830'S & 350'E
from center sec 10


- ⊗ C-81454 1900-8L
- ⊗ C-57115 supp-8L
- ⊗ C-74135 1903-51^o
- ⊗ C-57156 1977-3²oc.

T.15S., R.10E., W.M.

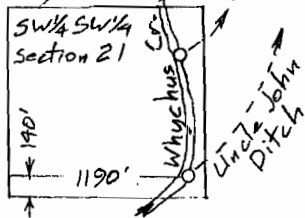

Scale 1" = 1320'

Claim of
Beneficial Use Map
for
Lazy Z Ranch

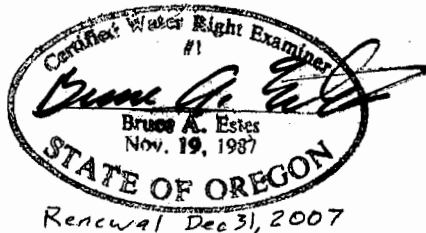

This map is for the purpose of locating a water right only and has no intent to provide legal dimensions or the location of property lines.

ESTES SURVEYS, LLC

PO Box 17610	60382 Arnold Rd
Salem, OR 97306-7519	Behd, OR 97702
(503) 585-7593	(541) 382-7391

Surveyed Aug 23 &
Sep 25, 2006

Amended 28 Apr 08

T. 15S, R. 10E, W.M.

Hwy 126

T-8900
T-8902

RECEIVED
MAR 06 2007
WATER RESOURCES DEPT
SALEM, OREGON

Claim of Beneficial Use
for
R&B RANCH, LLC

Well #2

- ✓ ⊕ C-45033 Supplemental to 1908 13²
 - ✓ ⊕ C-57115 Primary 12²
 - ✓ ⊕ C-57156 Supplemental to 1908 3²
- Whychus Creek (Three Sisters I.D.)
- ⊕ C-74135 1903 59²
 - ✓ ⊕ C-982 1908 40²
 - ✓ ⊕ C-2056 1912 14²



ESTES SURVEYS, LLC
 PO Box 17519 80382 Arnold Rd
 Salem, OR 97306-7519 Bend, OR 97702
 (503) 585-7593 (541) 382-7391

This map is for the purpose of locating a water right only and has no intent to provide legal dimensions or the locator of property lines.

Surveyed July 12, August 23 & December 29, 2006

scale 1" = 400'

T. 15S, R. 10E, W.M.
SW 1/4 SW 1/4 Section 21
1190'
Whychus
Uncle John Ditch
Scale 1" = 1320'

